

CLARKE MISSISSIPPI BOARD OF WATER COMMISSIONERS

3 M 7
6-62

WATER WELL DRILLERS LOG

Date: June, 1962, Driller: Peeples & Raulley County Clarke
(Name)

(1) Owner of Land: <u>Frank Day</u> (Name)	Description & Color of Materials Sand, Clay, Red Clay, Shell, etc.	Thick- ness Feet	Depth Feet
<u>Quitman, Miss</u> (Address)	<u>top white yellow sand</u>	<u>31</u>	<u>31</u>
<u>town of Quitman 2N 15E</u>	<u>Blue marl</u>	<u>34</u>	<u>65</u>
(2) Location: <u>1/4, 1/4, Sec. T R</u> <u>Eastwood Garden Sub-Division</u>	<u>soft lime + limestone</u>	<u>71</u>	<u>137</u>
_____ miles _____ of _____ (distance) (direction) (Nearest Town)	<u>Brown sandy shale</u>	<u>74</u>	<u>221</u>
(3) Topography: <u>flat</u> (Hill) (Flat) (Level)	<u>White + Brown sand</u>	<u>37</u>	<u>258</u>
(4) Purpose of Well: <u>Domestic</u> (Domestic Irrigation Municipal, Industrial, Other)			

Information upon completion of well:

(1) Diameter 2 inches.

(2) Total Depth 258 feet.

(3) Water Level 1/2 feet below top of ground.

(4) Cased to 252, Size 2"


(5) Screen: Size 2", Length 6"

(6) Were any formations sealed against pollution?
 yes, no.

If YES depth of formation _____

Why _____

Drillers Remarks: _____

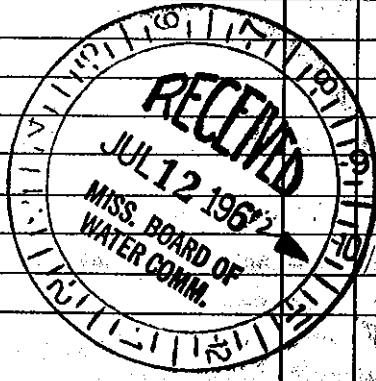

Well No.

(Use Back Side)

Mail this copy to Board of Water Commissioners 429 Miss. St. Jackson, Miss.