

Clarke
3 M 10
10-66

MISSISSIPPI BOARD OF WATER COMMISSIONERS

WATER WELL DRILLERS LOG

Date: 10-5, 1966, Driller: M^e Donald J. Hill County CLARK
(When well drilled) (Name) (Where well is located)


(1) Owner of Land: TERRY DECTON
(Name)
QUITMAN MISS
(Address)
 (2) Location: NE 1/4, NW 1/4, Sec. 7 T. 2 R. 15
(distance) (direction) (Nearest Town)
3 1/2 miles WEST of QUITMAN
(distance) (direction) (Nearest Town)
 (3) Topography: X
(Hilly) (Flat) (Level)
 (4) Purpose of Well: DOMESTIC
(Domestic Irrigation) (Municipal, Industrial, Other)

Description & Color of Materials Sand, Clay, Red Clay, Shell, etc.	Thick- ness Feet	Depth Feet
CLAY	8	8
CLAY ST SAND	18	26
SHALE ST SAND	39	65
SHALE	60	125
OYSTER SHELLS SAND	10	135
SHALE ST LIME ROCK SAND	55	180
	15	295

Information upon completion of well:

(1) Diameter: 3 1/2 inches. TEST HOLE
 (2) Total Depth: 295' feet.
 (3) Water Level: 55' feet below top of ground.
 (4) Cased to: 288', Size 2"
 (5) Screen: Size 2", Length 5'
 (6) Were any formations sealed against pollution?
 _____ yes, no.

If YES depth of formation _____
 Why _____
 Drillers Remarks: _____
 Yield in gpm: 5
 Size pump: 1 HP
 Type power: Electric

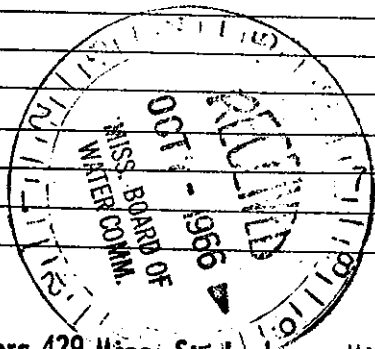

Mail this copy to Board of Water Commissioners 429 Miss. St. Jackson, Miss.