

CLARKE
SM 12
2-65

MISSISSIPPI BOARD OF WATER COMMISSIONERS

P

WATER WELL DRILLERS LOG

Date: Feb, 1965, Driller: Reeples Drilling Co County Clarke
(Name)

(1) Owner of Land:	Description & Color of Materials Sand, Clay, Red Clay, Shell, etc.	Thick- ness Feet	Depth Feet
<u>Billy Sellers</u> (Name)	<u>White sand</u>	<u>15</u>	<u>15</u>
<u>Quitman, Miss</u> (Address)	<u>Blue clay</u>	<u>15</u>	<u>30</u>
(2) Location: <u>town of De Soto</u> <u>1/4, 1/4, Sec. 36 T. 15E</u> <u>town of De Soto</u> miles (distance), of (direction), (Nearest Town)	<u>Green lime & limestone</u>	<u>80</u>	<u>110</u>
(3) Topography: <u>Flat</u> (Hilly) (Flat) (Level)	<u>Brown shale & sandy shale</u>	<u>17</u>	<u>127</u>
(4) Purpose of Well: <u>Home</u> (Domestic Irrigation, Municipal, Industrial, Other)	<u>Brown sand</u>	<u>47</u>	<u>174</u>


Information upon completion of well:

- (1) Diameter 2 inches.
- (2) Total Depth 174 feet.
- (3) Water Level 7 low feet below top of ground.
- (4) Cased to 168', Size 2"
- (5) Screen: Size 2", Length 6'
- (6) Were any formations sealed against pollution?
_____ yes, _____ no.

If YES depth of formation _____

Why _____

Drillers Remarks: _____

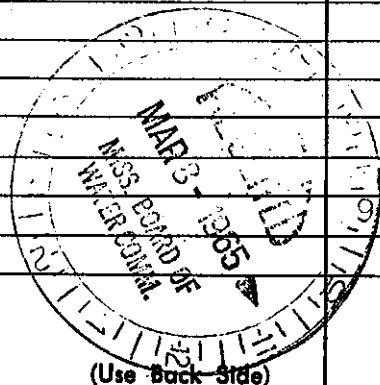

(Use Back Side)

Well No.

Mail this copy to Board of Water Commissioners 429 Miss. St. Jackson, Miss.