

CLARKE

MISSISSIPPI BOARD OF WATER COMMISSIONERS

M14

4-62


WATER WELL DRILLERS LOG

5 5

Date: April, 1962, Driller: Peoples & Hutchings County, Clarke

(Name)

(1) Owner of Land: <u>Methodist Church</u> (Name)	Description & Color of Materials Sand, Clay, Red Clay, Shell, etc.	Thick- ness Feet	Depth Feet
<u>Desota, Miss</u> (Address)	<u>Top to yellow sandy clay + yellow sand</u>	42	42
(2) Location: <u>Downstream</u> <u>1/4, 1/4, Sec. 36 21 15E</u> miles <u>Desota</u> (distance) (direction) (Nearest Town)	<u>lime + limestone</u>	73	115
	<u>Dark Brown sandy shale</u>	17	132
(3) Topography: <u>Flat</u> (Hilly) (Flat) (Level)	<u>Light brown sand</u>	28	160
(4) Purpose of Well: <u>Passage</u> (Domestic Irrigation Municipal, Industrial, Other)			
Information upon completion of well:			
(1) Diameter <u>2</u> inches.			
(2) Total Depth <u>160</u> feet.			
(3) Water level <u>75</u> feet below top of ground.			
(4) Cased to <u>152</u> , Size <u>2</u> "			
(5) Screen: Size <u>2</u> " , Length <u>6</u> '			
(6) Were any formations sealed against pollution? <u>yes</u> , <input checked="" type="checkbox"/> no.			
If YES depth of formation _____			
Why _____			
Drillers Remarks: _____			

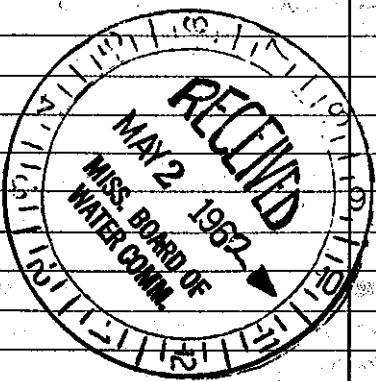

(Use Back Side)

Well No.

Mail this copy to Board of Water Commissioners 429 Miss. St. Jackson, Miss