

**CLARKE MISSISSIPPI BOARD OF WATER COMMISSIONERS**

**WATER WELL DRILLERS LOG 7**

3 M 16  
7-62

Date: July, 1962, Driller: Pepler & Rutledge County Clarke

(Name)

(1) Owner of Land: <u>Levin Atterberg</u> (Name)	Description & Color of Materials Sand, Clay, Red Clay, Shell, etc.	Thick- ness Feet	Depth Feet
<u>Quitman, Miss.</u> (Address)	<u>Top to yellow sandy clay</u>	<u>10</u>	<u>10</u>
(2) Location: <u>1/4, 1/4, Sec. 22 T. 2 R. 5E</u>	<u>Yellow sand</u>	<u>63</u>	<u>73</u>
<u>4</u> miles <u>SW</u> of <u>Quitman</u> (distance) (direction) (Nearest Town)	<u>Blue clay</u>	<u>43</u>	<u>136</u>
(3) Topography: <u>Hilly</u> (Hilly) (Flat) (Level)	<u>Green rock &amp; shale</u>		
(4) Purpose of Well: <u>Domestic</u> (Domestic Irrigation Municipal, Industrial, Other)	<u>strata</u>	<u>43</u>	<u>179</u>
	<u>Blue shale &amp; sandy</u>		
	<u>shale</u>	<u>20</u>	<u>199</u>
	<u>White sand</u>	<u>61</u>	<u>260</u>


Information upon completion of well:

- (1) Diameter 2" inches.
- (2) Total Depth 260 feet.
- (3) Water Level 120 feet below top of ground.
- (4) Cased to 254, Size 2"
- (5) Screen: Size 2", Length 6"
- (6) Were any formations sealed against pollution?  
yes,  no.

If YES depth of formation \_\_\_\_\_

Why \_\_\_\_\_

Drillers Remarks: \_\_\_\_\_

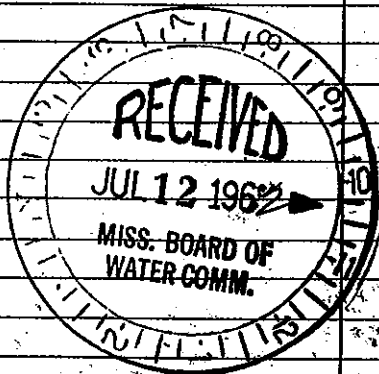

(Use Back Side)

Mail this copy to Board of Water Commissioners 429 Miss. St. Jackson, Miss.