

CLARKE MISSISSIPPI BOARD OF WATER COMMISSIONERS


M19

WATER WELL DRILLERS LOG 4 M 300'

10-8-60

Date: 10-8, 1960, Driller: Peoples of Ross County, Clarke
(Name)

(1) Owner of Land: Mrs. B. H. Les (Name)	Description & Color of Materials Sand, Clay, Red Clay, Shell, etc.	Thick- ness Feet	Depth Feet
Desoto Miss (Address)	Yellow Sand	25	25
(2) Location: 1/4, 1/4, Sec 35 T2 R15	Gray Shale	33	58
_____ miles _____ of _____ (distance) (direction) (Nearest Town)	Green Lined Shale	68	126
(3) Topography: River Bottom - (Hilly) (Flat) (Level)	Gray Sandy Shale	21	147
(4) Purpose of Well: Domestic (Domestic Irrigation Municipal, Industrial, Other)	Brown Sandy Shale	30	177
Information upon completion of well:	a Sand Patch		
(1) Diameter 2 inches.	Brown Sand -	11	178
(2) Total Depth 178 feet.			
(3) Water Level 45 feet below top of ground.			
(4) Cased to 178, Size 2"			
(5) Screen: Size 2", Length 6'			
(6) Were any formations sealed against pollution? _____ yes, _____ no.			
If YES depth of formation _____			
Why _____			
Drillers Remarks: _____			

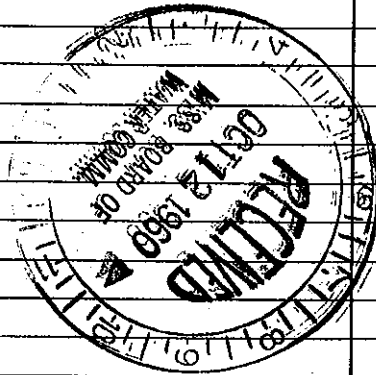

(Use Back Side)

Well No.

Mail this copy to Board of Water Commissioners 429 Miss. St. Jackson, Miss.