

CLARKE MISSISSIPPI BOARD OF WATER COMMISSIONERS

6M23

10-10-63

WATER WELL DRILLERS LOG

P

Date: 10-10, 1963, Driller: McDonald & Hill County, Clarke
(Name)

(1) Owner of Land: <u>BB Rice</u> (Name)	Description & Color of Materials Sand, Clay, Red Clay, Shell, etc.	Thick- ness Feet	Depth Feet
(Address)	Clay	6	5
(2) Location: <u>1/4, 2N15E</u> <u>7 T R</u>	Sand	5	10
<u>6</u> miles <u>west</u> of <u>Quitman</u> (distance) (direction) (Nearest Town)	Shale	15	25
(3) Topography: <u>Hilly</u> (Hilly) (Flat) (Level)	finer shale + lime	30	110
(4) Purpose of Well: <u>Domestic</u> (Domestic Irrigation Municipal, Industrial, Other)	Sand w/ shale st.	110	113
	Brown shale	113	120
	Soft shale w/ sh. st.	120	130
	Coarse sand	130	175


Information upon completion of well:

- (1) Diameter 3 1/4 inches.
- (2) Total Depth 175 feet.
- (3) Water Level 24 feet below top of ground.
- (4) Cased to 170, Size 2"
- (5) Screen: Size 2", Length 5'
- (6) Were any formations sealed against pollution?
_____ yes, _____ no.

If YES depth of formation _____

Why _____

Drillers Remarks: _____

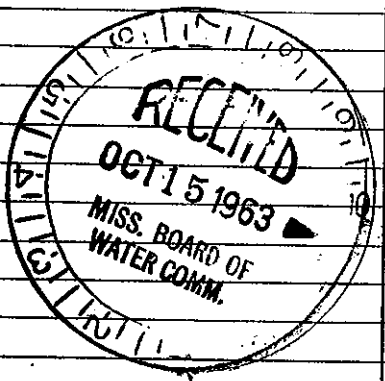

Well No.
117

(Use Back Side)

Mail this copy to Board of Water Commissioners 429 Miss. St. Jackson, Miss.