

CLARKS MISSISSIPPI BOARD OF WATER COMMISSIONERS

6 M 24
11-2-63

WATER WELL DRILLERS LOG

P

Date: 11-2, 1963, Driller: Mc Donald & Hill County Clarke
(Name)

	Description & Color of Materials Sand, Clay, Red Clay, Shell, etc.	Thick- ness Feet	Depth Feet
(1) Owner of Land: <u>Henry Kield</u> (Name) <u>Rt # 3, Quitman, Miss</u> (Address)	Clay	0	17
	Red gravel	17	19
	Clay	19	25
(2) Location: <u>1/4, 1/4, Sec. 7 2N 15E</u> <u>5 miles west</u> of <u>Quitman</u> (distance) (direction) (Nearest Town)	Brown sand	25	36
	Shell	36	44
	Coarse sand	44	55
(3) Topography: <u>Hilly</u> (Hilly) (Flat) (Level)			
(4) Purpose of Well: <u>Domestic</u> (Domestic Irrigation Municipal, Industrial, Other)			

Information upon completion of well:

(1) Diameter 3 7/8 inches.

(2) Total Depth 55 feet.

(3) Water Level 47 feet below top of ground.

(4) Cased to 49, Size 2"


(5) Screen: Size 2", Length 6'

(6) Were any formations sealed against pollution?
_____ yes, _____ no.

If YES depth of formation _____

Why _____

Drillers Remarks: _____

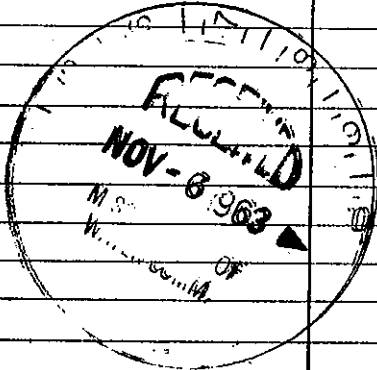

Well No.

(Use Back Side)

Mail this copy to Board of Water Commissioners 429 Miss. St. Jackson, Miss.