


CLARKE MISSISSIPPI BOARD OF WATER COMMISSIONERS

WATER WELL DRILLERS LOG

M26
4-29-64

Date: 4-29, 1964, Driller: McDonald Hillway

(Name)

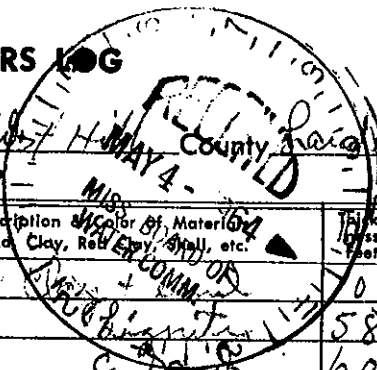

(1) Owner of Land: WALTER THOMPSON
(Name)

DUITMAN MISS
(Address)

(2) Location: 1/4, 1/4, Sec. 11 T. 15 N. R. 11 E

miles of (distance) (direction) (Nearest Town)

(3) Topography: HILLY
(Hilly) (Flat) (Level)

(4) Purpose of Well: DOMESTIC
(Domestic Irrigation, Municipal, Industrial, Other)

Description of Material Sand, Clay, Red Clay, Shell, etc.	Thickness of Foot	Depth Feet
	0	58
lignite + sand str.	58	60
same + lime rocks	60	82
sandy lime	82	90
shale + lime rock str.	90	110
shale + sandy slate	110	120
no. 10 sand	120	230
shale + sand str.	230	255
	255	280
	280	290

Information upon completion of well:

(1) Diameter 4 inches.

(2) Total Depth 290 feet.

(3) Water Level 87 feet below top of ground.

(4) Cased to 151, Size 4

(5) Screen: Size, Length

(6) Were any formations sealed against pollution?

yes, no.

If YES depth of formation

Why

Drillers Remarks:

Well No.

(Use Back Side)

Mail this copy to Board of Water Commissioners 429 Miss. St. Jackson, Mis: