

CLARK
6 M27
4-8-63

MISSISSIPPI BOARD OF WATER COMMISSIONERS

McDonald & Bell

WATER WELL DRILLERS LOG

Date: 4-8, 1963, Driller: Lee B. Chatham County Clarke
(Name)

(1) Owner of Land: Charlie Riley
(Name)
Quitman, Miss
(Address)

(2) Location: 1/4, 1/4, Sec. 11 2 15
T R
miles _____ of _____
(distance) (direction) (Nearest Town)

(3) Topography: Hilly
(Hilly) (Flat) (Level)

(4) Purpose of Well: Domestic
(Domestic Irrigation
Municipal, Industrial, Other)

Description & Color of Materials Sand, Clay, Red Clay, Shell, etc.	Thick- ness Feet	Depth Feet
Clay	0	7
sand	7	35
sand-sandy clay	35	40
shale w/ sil. streaks	40	45
shale	45	62
sil. w/ shale breaks	52	68
shale	60	92
limy shale	92	108
limy sand & lime	108	118
lime rock	118	122
shale	122	130
sandy shale	130	135
lime rock	135	136
sandy shale	136	147
shale	147	158
sandy shale & sand	158	162
shale	162	167
sand	167	210

Information upon completion of well:

(1) Diameter 3/4 inches.

(2) Total Depth 210 feet.

(3) Water Level 90 feet below top of ground.

(4) Cased to 128, Size 4


(5) Screen: Size _____, Length _____

(6) Were any formations sealed against pollution?
_____ yes, _____ no.

If YES depth of formation _____

Why _____

Drillers Remarks: _____

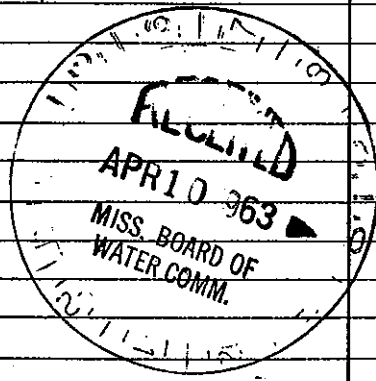

Well No.

(Use Back Side)

Mail this copy to Board of Water Commissioners 429 Miss. St. Jackson, Miss