

CLARKE MISSISSIPPI BOARD OF WATER COMMISSIONERS

5M29

4-12-63

WATER WELL DRILLERS LOG

Date: 4-12, 1963, Driller: Mr. Donald H. H. Fre
Leff Chatham County Clay

(Name)

(1) Owner of Land	Description & Color of Materials Sand, Clay, Red Clay, Shell, etc.	Thick- ness Feet	Depth Feet
<u>Dennis A. Theberry</u> (Name)	<u>Clay</u>	<u>0</u>	<u>11</u>
<u>Quitman Miss.</u> (Address)	<u>Sand</u>	<u>11</u>	<u>46</u>
(2) Location: <u>1/4</u> , <u>1/4</u> , Sec. <u>21 2 15</u> T R	<u>Shale</u>	<u>46</u>	<u>51</u>
<u>4</u> miles <u>SW</u> of <u>Quitman</u> (distance) (direction) (Nearest Town)	<u>Sand shale break</u>	<u>51</u>	<u>62</u>
(3) Topography: <u>Hilly</u> (Hilly) (Flat) (Level)	<u>Shale</u>	<u>62</u>	<u>105</u>
(4) Purpose of Well: <u>Domestic</u> (Domestic Irrigation Municipal, Industrial, Other)	<u>Thinny shale</u>	<u>105</u>	<u>135</u>
	<u>Soly. lime & shale</u>	<u>135</u>	<u>140</u>
	<u>Thinny shale</u>	<u>140</u>	<u>180</u>
	<u>Shale</u>	<u>180</u>	<u>195</u>
	<u>Sand</u>	<u>195</u>	<u>210</u>


Information upon completion of well:

- (1) Diameter 3 1/4 inches.
- (2) Total Depth 210 feet.
- (3) Water Level 115 feet below top of ground.
- (4) Cased to 205, Size 2"
- (5) Screen: Size 2", Length 5'
- (6) Were any formations sealed against pollution?
_____ yes, _____ no.

If YES depth of formation _____

Why _____

Drillers Remarks: _____

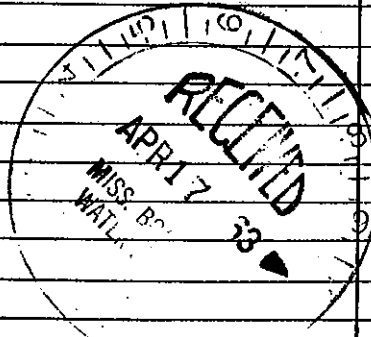

Well No.

(Use Back Side)

Mail this copy to Board of Water Commissioners 429 Miss. St. Jackson, Miss