

CLARKE MISSISSIPPI BOARD OF WATER COMMISSIONERS


M30

P.

5 8-21-63 WATER WELL DRILLERS LOG

Date: 8-21, 19___, Driller: McDonald & Hill County Clarke
(Name)

(1) Owner of Land	Description & Color of Materials Sand, Clay, Red Clay, Shell, etc.	Thick- ness Feet	Depth Feet
<u>Lewis Smith</u> (Name) <u>Rt. #3, Quitman, Miss</u> (Address)	<u>Clay</u>	<u>17</u>	<u>0</u>
(2) Location: <u>1/4</u> , <u>1/4</u> , Sec <u>23</u> T. <u>2</u> R. <u>15</u>	<u>Shale</u>	<u>21</u>	<u>21</u>
<u>3</u> miles <u>South</u> of <u>Quitman</u> (distance) (direction) (Nearest Town)	<u>Shale</u>	<u>75</u>	<u>75</u>
(3) Topography: <u>Hilly</u> (Hilly) (Flat) (Level)	<u>Sandy red shale</u>	<u>85</u>	<u>85</u>
(4) Purpose of Well: <u>Domestic</u> (Domestic Irrigation Municipal, Industrial, Other)	<u>Coarse sand</u>	<u>96</u>	<u>96</u>

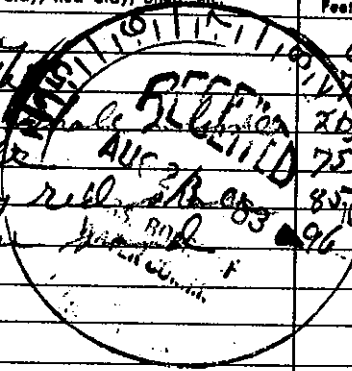

Information upon completion of well:

(1) Diameter 3 7/8 inches.

(2) Total Depth 105 feet.

(3) Water Level 35 feet below top of ground.

(4) Cased to 105, Size 2"

(5) Screen: Size 2", Length 6'

(6) Were any formations sealed against pollution?
_____yes, _____no.

If YES depth of formation _____

Why _____

Drillers Remarks: _____

Well No. #499

(Use Back Side)

Mail this copy to Board of Water Commissioners 429 Miss. St. Jackson, Miss