

5/11/33
9-7-60

WATER WELL DRILLERS LOG Form # 1

Date: 9-7, 1960, Driller: Peoples Pottery County, Clarke
(Name)

(1) Owner of Land: R. B. Kennedy
(Name)

Route #2 Gortm
(Address)

(2) Location: 1/4, 1/4, Sec. 31 T. R.
2N 15E

6 miles West of Jesofa.
(distance) (direction) (Nearest Town)

(3) Topography: Hilly
(Hilly) (Flat) (Level)

(4) Purpose of Well: Stock
(Domestic Irrigation, Municipal, Industrial, Other)

Description & Color of Materials Sand, Clay, Red Clay, Shell, etc.	Thick- ness Feet	Depth Feet
Red Sandy Clay	12	12
Gray Sandy Shale	37	49
Gray Fine Sand	13	62
Sand & Shale Veins	42	104
Gray Shale	42	146
Green Shale Lime Bks	21	167
Lime	32	199
Limey Shale	21	220
Red Shale	8	228
Brown to White Sand	24	252

Information upon completion of well:

(1) Diameter 4 inches.

(2) Total Depth 252 feet.

(3) Water Level 87' feet below top of ground.

(4) Cased to 106', Size 4"

(5) Screen: Size _____, Length _____


(6) Were any formations sealed against pollution?

_____ yes, _____ no.

If YES depth of formation _____

Why _____

Drillers Remarks: _____

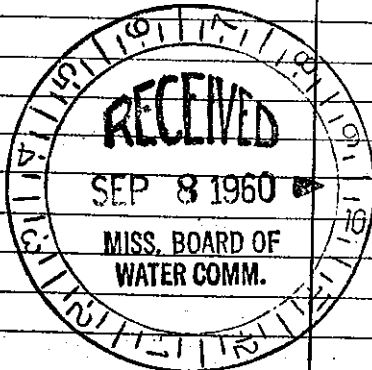

Well No.

(Use Back Side)

Retain this copy for your office files.