

CLARKE MISSISSIPPI BOARD OF WATER COMMISSIONERS

S Q M34
9-2-60

WATER WELL DRILLERS LOG

L. M. P.

Date: 9-2, 1960, Driller: Peoples & Rodgers County Clarke
(Name)

(1) Owner of Land: R. W. Kennedy
(Name)
Route #2 Quitman Miss
(Address)
2 N 150

(2) Location: 1/4, 1/4, Sec. 31 T. R.
5 miles west, of De Soto
(distance) (direction) (Nearest Town)

(3) Topography: Hilly
(Hilly) (Flat) (Level)

(4) Purpose of Well: Stock
(Domestic Irrigation
Municipal, Industrial, Other)

Description & Color of Materials Sand, Clay, Red Clay, Shell, etc.	Thick- ness Feet	Depth Feet
<u>Yellow Sandy Clay</u>	<u>12</u>	<u>12</u>
<u>Gray sandy shale</u>	<u>8</u>	<u>20</u>
<u>Gray shale</u>	<u>21</u>	<u>41</u>
<u>Gray sand & lignite</u>	<u>11</u>	<u>52</u>
<u>Sand & shale lens</u>	<u>31</u>	<u>83</u>
<u>Shale (hard)</u>	<u>32</u>	<u>115</u>
<u>Green limy shale</u>	<u>19</u>	<u>124</u>
<u>lime (hard streak)</u>	<u>52</u>	<u>176</u>
<u>limy shale</u>	<u>7</u>	<u>185</u>
<u>Brown shale</u>	<u>11</u>	<u>196</u>
<u>Brown to white sand</u>	<u>24</u>	<u>220</u>

Information upon completion of well:

(1) Diameter 4 inches.

(2) Total Depth 220 feet.

(3) Water Level 50 feet below top of ground.

(4) Cased to 88, Size 4"


(5) Screen: Size _____, Length _____

(6) Were any formations sealed against pollution?
_____ yes, _____ no.

If YES depth of formation _____

Why _____

Drillers Remarks: _____

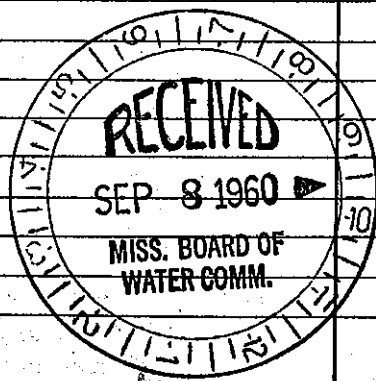

(Use Back Side)

Well No.

Mail this copy to Board of Water Commissioners 429 Miss. St. Jackson, Miss.