

CLARKE

MISSISSIPPI BOARD OF WATER COMMISSIONERS

M 85

WATER WELL DRILLERS LOG

5-19-65

Date: 19 65, Driller: Mr. Donald Hill, County: Land.

(Name)

(1) Owner of Land: Luther Meace
 (Name)
#3, Quitman, Miss.
 (Address)

(2) Location: $\frac{1}{4}$ Sec. 7, T. 2N, R. 15E
6 miles E of Pacheta
 (distance) (direction) (Nearest Town)

(3) Topography: (Hilly) (Flat) (Level)

(4) Purpose of Well: Domestic
 (Domestic Irrigation, Municipal, Industrial, Other)

Description & Color of Materials Sand, Clay, Red Clay, Shell, etc.	Thick- ness Feet	Depth Feet
Clay	0	20
lig. brown shale	20	25
yellow clay fine sand	25	60
OC sand & clay etc.	60	70
yellow clay & sand	70	100
white sand & clay	100	110
shale	110	163
O. shells	163	165
fine rock	165	210
brown shale	210	222
fine sand	222	240
OC sand	240	260

Information upon completion of well:

(1) Diameter 4 inches.

(2) Total Depth 260 feet.

(3) Water Level 89 feet below top of ground.

(4) Cased to 150 355 Size 4" x 2"


(5) Screen: Size 2, Length 5 ft.

(6) Were any formations sealed against pollution?
 yes, no.

If YES depth of formation _____

Why _____

Drillers Remarks: _____

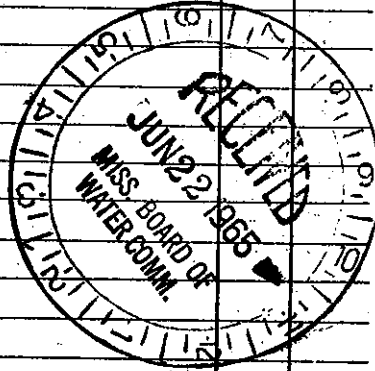

Well No.

(Use Back Side)

Retain this copy for your office files.