

Clarke
M 44
5-22-64

MISSISSIPPI BOARD OF WATER COMMISSIONERS

WATER WELL DRILLERS LOG

Date: 5.22, 1964, Driller: _____ County Clarke

(Name)

(1) Owner of Land	Description & Color of Materials Sand, Clay, Red Clay, Shell, etc.	Depth Feet
<u>ALFORD EVENS</u> (Name)	<u>CLAY</u>	<u>0 9</u>
<u>QUITMAN</u> (Address)	<u>SAND</u>	<u>9 15</u>
(2) Location: <u>1/4</u> , <u>18</u> , Sec. <u>22-15E</u> , T. <u>R</u>	<u>SHALE</u>	<u>15 110</u>
<u>4</u> miles <u>WEST</u> , of <u>QUITMAN</u>	<u>FINE SAND ST SHALE</u>	<u>110 180</u>
(distance) (direction) (Nearest Town)	<u>SOFT SHALE</u>	<u>180 225</u>
(3) Topography: <u>X</u>	<u>SAND NO 14: 18</u>	<u>225 238</u>
(Hilly) (Flat) (Level)		
(4) Purpose of Well: <u>DOMESTIC</u> (Domestic Irrigation Municipal, Industrial, Other)		

CODED

Information upon completion of well:


- (1) Diameter 3 1/2 inches. TEST HOLE
- (2) Total Depth 238' feet.
- (3) Water Level 24' feet below top of ground.
- (4) Cased to 231', Size 2"
- (5) Screen: Size 2", Length 5'
- (6) Were any formations sealed against pollution?
_____ yes, _____ no.

CODED

If YES depth of formation _____

Why _____

Drillers Remarks: _____

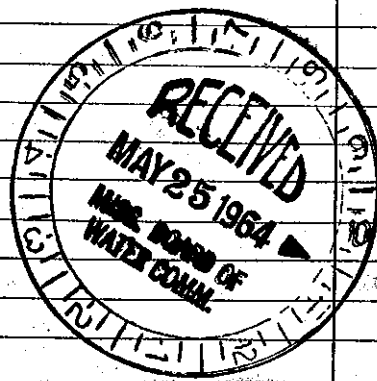

Well No. _____

(Use Back Side)

Mail this copy to Board of Water Commissioners 429 Miss. St. Jackson, Miss