

State Well Report

Part 1

Mississippi Department of Environmental Quality
 Office of Land and Water Resources
 P.O. Box 10631
 Jackson, MS 39289-0631
 (601)961-5210
 (601)354-6938 (fax)
 601-360-0535

For Office Use Only:

Aquifer: _____
 Well #: M88
 L. S. Elevation: _____
 E-log #: _____

County: Clarke
 Permit #: _____
 Driller: Cain
 Date drilling completed: 12-21-10

State Law requires that this report be prepared by the driller in detail and filed with the Department within 30 days of completion of drilling of the well.

Well Owner Information	Well Location
Owner Name: <u>George Sellers</u>	Latitude: <u>31° 57' 57"</u> Longitude: <u>88° 42' 30"</u>
Mailing Address: <u>218 Woodlyn Dr</u>	Method of Lat/Long (circle one): Conventional Survey,
<u>Quitman Ms 39355</u>	USGS quad, Hand-held GPS, Survey-grade GPS
City State Zip Code	<u>S 1/4 E 1/4 Sec 36 Twn 2N R15E</u>
Telephone No. <u>(601) 779-3207</u>	Distance <u>5</u> Miles <u>South</u> of <u>Quitman Ms</u>

Well Data

Purpose of Well (circle one): Home Industrial Public Supply Irrigation Fish Culture Other: _____

Date well drilling started: 12-21-10 Date well drilling completed: 12-21-10

If flowing, method of flow regulation: Valve _____ Other (describe) _____

Static Water Level: 15' feet above or below (circle one) land surface Date measured: 12-21-10

Method of Measurement (circle one): steel tape electric tape air line other: _____

Hole depth: 40 Well depth: 40 Well grouted to a depth of 10 feet

Type of grout (circle one): Cement Bentonite Mix

Casing length: 30 feet Casing diameter: 2 inches Type of casing: PVC

Screen length: 10 feet Screen diameter: 2 inches Type of screen: PVC

Screen slot size: #10 inches Setting depth: From 30 feet to 40 feet

Type of completion (circle all applicable): Gravel packed Underreamed Telescoped Open hole Natural Development

Other (describe): _____

Top of lap pipe or reduction in casing: _____ feet. If telescoped or more than one screen, describe on back of page

Logs run (circle all applicable): No log run Electric Gamma Ray Density Sonic Neutron Other: _____


Name of organization running log(s): _____

I certify that the well was drilled, constructed, and completed in accordance with all applicable requirements of the Mississippi Department of Environmental Quality and/or the Mississippi Department of Health regulations and state laws.

Nelson Cain 0-374 Nelson Cain
 Print Name of Water Well Contractor and License No. Signature of Water Well Contractor

RECEIVED
 JAN 26 2011
 BY: OLWR


If well telescopes please sketch below and show depths.

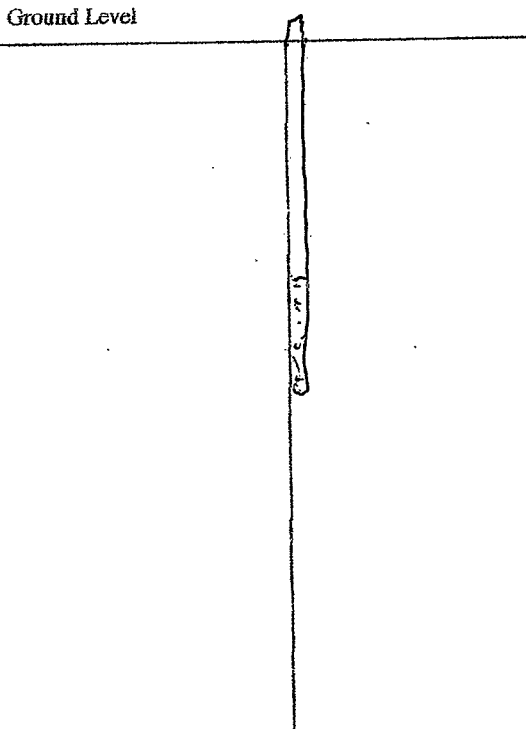

Description of Formations Encountered	From	To
Top Soil & Sand	0	15
Clay	15	20
Sand	20	40

If more than one screen, show location of each on sketch

Sketch the property layout and include the following: 1) the well location; 2) any permanent structures on the property that may aid in locating the well; 3) any roads, power lines, or other items that may aid in locating the property and the well; 4) indicate direction.

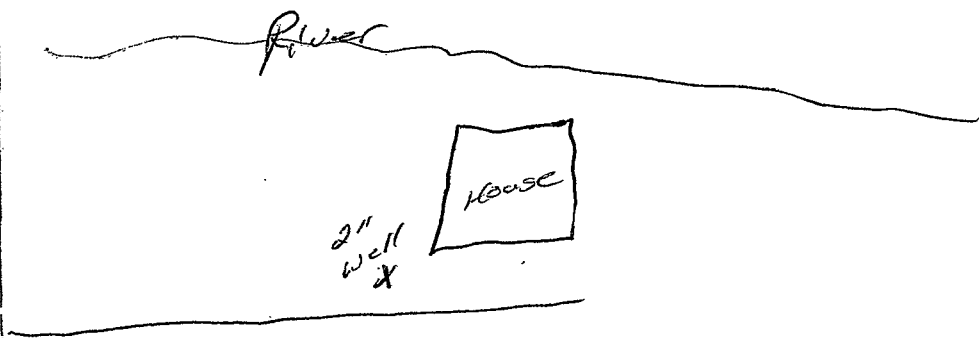

Landowner Name: George Sellers

Nelson Cain
Signature of Water Well Contractor

RECEIVED
JAN 26 2011
BY: OLWR

STATE WELL REPORT

Part 2

Pump Installer's Completion Report
 Mississippi Department of Environmental Quality
 Office of Land and Water Resources
 P.O. Box 10631
 Jackson, MS 39289-0631
 (601)961-5210
 (601)354-6938 (fax)

County: Clarke
 Permit #: _____
 Driller: Cain
 Date completed: 12-21-10

For Office Use Only:

Aquifer: _____
 Well #: M88
 Elevation: _____

This report should be prepared by the pump installer in detail and filed with the Department within 30 days of the installation of pump.

Well Owner Information	Well Location
Owner Name: <u>George Sellers</u>	Latitude: <u>31-57-57</u> Longitude: <u>88-42-30</u> ^W
Mailing Address: <u>218 Woodlyn Dr</u>	Method of Lat/Long (circle one): Conventional Survey, USGS quad, Hand-held GPS, Survey-grade GPS
<u>Quitman</u> MS <u>39355</u> City State Zip Code	<u>SE</u> 1/4 <u>SE</u> 1/4 Sec. <u>36</u> Twn <u>2N</u> , Rng <u>15E</u>
Telephone No. <u>(601) 779-3207</u>	Distance Direction Nearest Town <u>5</u> Miles <u>South</u> of <u>Quitman MS</u>

Pump Type Circle one	Power Type Circle one
Air Lift <input checked="" type="radio"/> Jet <input type="radio"/> Submersible	Diesel Engine <input type="radio"/> Gasoline Engine <input type="radio"/> Natural Gas
Bucket <input type="radio"/> Piston <input type="radio"/> Turbine	<input checked="" type="radio"/> Electric Motor <input type="radio"/> Hand <input type="radio"/> Tractor PTO
Centrifugal <input type="radio"/> Rotary <input type="radio"/> Flowing Well	Windmill <input type="radio"/> Other (specify): _____
Other (specify): _____	Horse Power Rating of Motor: <u>1</u>
Date Pump Installed: <u>12-21-10</u>	Setting Depth: <u>30'</u> feet
Rated Pump Capacity: <u>7</u> Gallons Per Minute	Number of Stages: <u>2</u>

Pump Test Data	Method of Measuring Water Level Circle one
Date Well Tested: <u>12-21-10</u>	Air Line <input type="radio"/> Electric Measuring Line <input type="radio"/> <input checked="" type="radio"/> Steel Tape
Static Water Level (A): <u>30</u> Feet Below Land Surface	Other (specify): _____
Pumping Water Level (B): _____ Feet Below Land Surface	For flowing well, measured shut in head: _____ feet
Drawdown [(B) - (A)]: _____ Feet Below Land Surface	Well yielded <u>6</u> GPM with a drawdown of _____ feet after <u>4</u> hours of pumping
Test Pumping Rate: <u>6</u> Gallons Per Minute	
Duration of Pump Test (minimum 4 hours): <u>4</u> hours	

I HEREBY CERTIFY that the above statements are true to the best of my knowledge.

Nelson Cain 0-374 Nelson Cain
 Print Name of Pump Installer and License No. (if applicable) Signature of Pump Installer

RECEIVED

JAN 26 2011

BY: OLWR