

MISSISSIPPI BOARD OF WATER COMMISSIONERS

63

WATER WELL DRILLERS LOG

17, 1963, Driller: McDonald & Hill County Clarke
(Name)

(1) Owner of Land: Pet Robinson
(Name)

(Address)

(2) Location: $\frac{1}{4}$, $\frac{1}{4}$, Sec. 24 ^{2 16} T. R.
8 miles SE of Quitman
(distance) (direction) (Nearest Town)

(3) Topography: Hilly
(Hilly) (Flat) (Level)

(4) Purpose of Well: Domestic
(Domestic Irrigation
Municipal, Industrial, Other)

Description & Color of Materials Sand, Clay, Red Clay, Shell, etc.	Thick- ness Feet	Depth Feet
Clay	0	10
Sol.	10	26
Shale	26	60
Limy shale	60	65
Limy shale upper st.	65	72
Limy shale	72	79
Soft limy shale	79	89
Hard limy shale	89	98
Shale	98	109
Sdy shale & sol.	109	114
Sdy shale w/ lime st.	114	135
Shale	135	146
Brown shale	146	148
Sol.	148	158
Shale	158	167
Sol.	167	186
Red gravel	186	190
Sol.	190	203
Lignite	203	205
Sand	205	260

Information upon completion of well:


(1) Diameter 3 1/4 inches.
(2) Total Depth 260 feet.
(3) Water Level 110 feet below top of ground.
(4) Cased to 231, Size 3"
(5) Screen: Size 2", Length 5'

(6) Were any formations sealed against pollution?
_____ yes, _____ no.

If YES depth of formation _____

Why _____

Drillers Remarks: _____

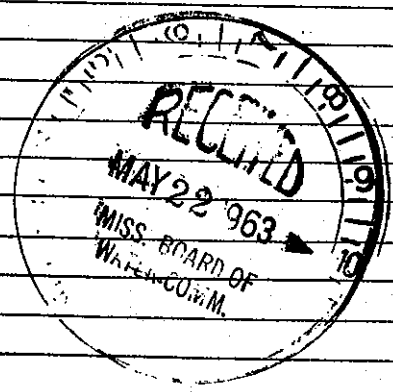

Well No.

(Use Back Side)

Mail this copy to Board of Water Commissioners 429 Miss. St. Jackson, Miss