

MISSISSIPPI BOARD OF WATER COMMISSIONERS

CLARKE

Sched

WATER WELL DRILLERS LOG

6 P

3 N1
9-62

6

Date: Sept, 1962, Driller: Keegan + Rutledge County Clarke
 HOLLOWMAN (Name)

(1) Owner of Land:	Description & Color of Materials Sand, Clay, Red Clay, Shell, etc.	Thick- ness Feet	Depth Feet
(Name) <u>Ozie Henry Hollowman</u> (Address) <u>Quitman, Miss</u>	<u>top to red sand + sandy clay</u>	<u>21</u>	<u>21</u>
(2) Location: <u>NE 1/4, NE 1/4, Sec. 4 T2R16</u> <u>3 1/2</u> miles <u>E</u> of <u>Quitman</u> (distance) (direction) (Nearest Town)	<u>Black lignite + Black sandy shale</u>	<u>53</u>	<u>74</u>
(3) Topography: <u>Hilly</u> (Hilly) (Flat) (Level)	<u>lime + limestone</u>	<u>83</u>	<u>157</u>
(4) Purpose of Well: <u>Domestic</u> (Domestic Irrigation Municipal, Industrial, Other)	<u>Green limey shale</u>	<u>17</u>	<u>174</u>
	<u>white sand</u>	<u>21</u>	<u>195</u>

Information upon completion of well:

(1) Diameter 2 inches.

(2) Total Depth 195 feet.

(3) Water Level 60 feet below top of ground.

(4) Cased to 189', Size 2"


(5) Screen: Size 2", Length 6'

(6) Were any formations sealed against pollution?
 _____ yes, no.

If YES depth of formation _____

Why _____

Drillers Remarks: _____

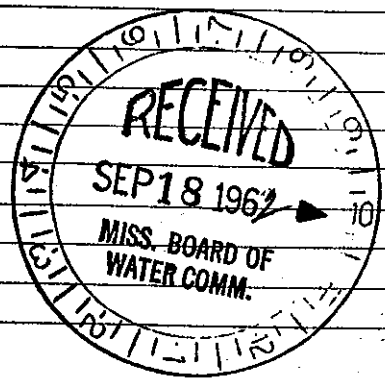

(Use Back Side)

Well No.

Mail this copy to Board of Water Commissioners 429 Miss. St. Jackson, Miss.