

CLARKE

MISSISSIPPI BOARD OF WATER COMMISSIONERS

3 N 2  
4-62


WATER WELL DRILLERS LOG

Date: April, 1962, Driller: Peepert & Ambly County Clarke  
V.D. LAMBIRTH (Name)

(1) Owner of Land: <u>V.D. Lambirth</u> (Name)	Description & Color of Materials Sand, Clay, Red Clay, Shell, etc.	Thick- ness Feet	Depth Feet
<u>Rt 2 Quitman, Miss</u> (Address)	<u>top to yellow sand &amp; sandy clay</u>	<u>31</u>	<u>31</u>
(2) Location: <u>SW 1/4, SE 1/4, Sec. 4 T2R16</u>	<u>Blue mud</u>	<u>32</u>	<u>63</u>
<u>3 1/2 miles E of Quitman</u> (distance) (direction) (Nearest Town)	<u>Blue mud &amp; gray sand strata</u>	<u>11</u>	<u>74</u>
(3) Topography: <u>Hilly</u> (Hilly) (Flat) (Level)	<u>gray sand</u>	<u>2</u>	<u>76</u>
(4) Purpose of Well: <u>Domestic</u> (Domestic Irrigation Municipal, Industrial, Other)	<u>Gray shale</u>	<u>40</u>	<u>116</u>
	<u>Green lime &amp; limestone</u>	<u>83</u>	<u>199</u>
	<u>white sand &amp; shell</u>	<u>59</u>	<u>258</u>
	<u>gray shale strata</u>		

Information upon completion of well:

- (1) Diameter 2 inches.
- (2) Total Depth 258 feet.
- (3) Water Level 96 feet below top of ground.
- (4) Cased to 252, Size 2"
- (5) Screen: Size 2", Length 6"
- (6) Were any formations sealed against pollution?  
\_\_\_\_\_yes, \_\_\_\_\_no.

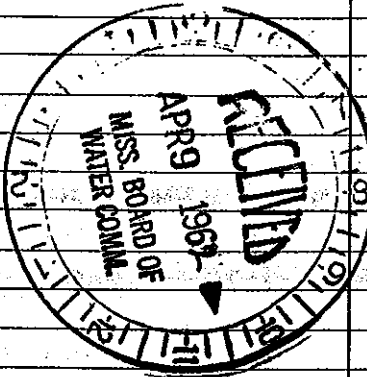

If YES depth of formation \_\_\_\_\_

Why \_\_\_\_\_

Drillers Remarks: \_\_\_\_\_

Well No. \_\_\_\_\_

(Use Back Side)

Mail this copy to Board of Water Commissioners 429 Miss. St. Jackson, Miss