

Clarke
3 N 7
11-66

MISSISSIPPI BOARD OF WATER COMMISSIONERS

P

WATER WELL DRILLERS LOG

Date: 11-15, 1966, Driller: M. E. Donald & H. H. In County Clarke
(When well drilled) (Name) (Where well is located)

(1) Owner of Land: HAL MAYO
(Name)
QUITMAN MISS
(Address)
 (2) Location: NE 1/4, SE 1/4, Sec. 13 T2 R16, N E
7 miles EAST, of QUITMAN
(distance) (direction) (Nearest Town)
 (3) Topography: X
(Hilly) (Flat) (Level)
 (4) Purpose of Well: DOMESTIC
(Domestic Irrigation Municipal, Industrial, Other)

Description & Color of Materials Sand, Clay, Red Clay, Shell, etc.	Thick- ness Feet	Depth Feet
CLAY ST SAND	30	30
SAND ST SHALE	25	55
SHALE	40	95
SHELLS ST SAND	23	118
SANDY LIME SHALE	34	152
BROWN SHALE ST SAND	36	188
FINE SAND ST SHALE	45	265
WHITE SAND	15	280

Information upon completion of well:

(1) Diameter 4" WELL inches.
 (2) Total Depth 280' feet.
 (3) Water Level 104 feet below top of ground.
 (4) Cased to 180, Size 4"
105, Size 2"
 (5) Screen: Size 2", Length 5'
 (6) Were any formations sealed against pollution?
 _____ yes, X no.

If YES depth of formation _____


Why _____

Drillers Remarks: _____

Yield in gpm: 60

Size pump: 3/4 HP SUBMERSIBLE PUMP

Type power: _____

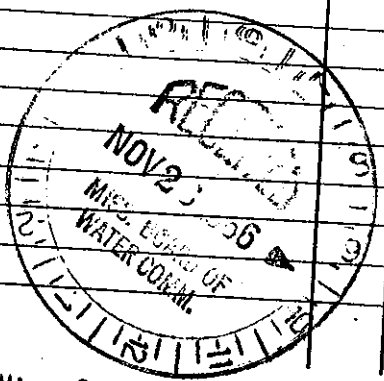

Mail this copy to Board of Water Commissioners 429 Miss. St. Jackson, Miss.