

Clarke
3 N 9
4-67

MISSISSIPPI
BOARD OF WATER COMMISSIONERS
416 North State Street
Jackson, Mississippi 39201

WATER WELL DRILLERS LOG

APRIL 1967 PEEPLES DRILLING CO CLARKE
date well completed firm name county well located

LANDOWNER: KEUCLEVE MCFARLAND
QUITMAN, MISS
(mailing address)

WELL LOCATION: 16
sec. 21 T. 2 N R. 3 E S
3 1/2 miles SE of QUITMAN
(distance) (direction) (nearest town)


WELL PURPOSE: HOME
(home, irrigation, municipal, industrial)

WELL COMPLETION DATA:

- (1) diameter (inches) 2
- (2) total depth (feet) 258
- (3) static water level (feet) 100 below top of ground.
- (4) casing GALV 252
(material) (depth)
2" if telescope see back.
(size)
- (5) screen 6' 252
(length) (depth to top)
2" BRASS
(size) (material)
- (6) pump 1 6
(HP) (yield gpm)
ELECT
(type power)
- (7) electric log NO
(yes or no)

(organization running log)
- (8) how well bottom plugged BACK
WASH VALVE

description of formations encountered	from	to
YELLOW SAND + SANDY CLAY	0	42
GRAY SHALE + SAND	42	63
GRAY SHALE	63	84
LIME + LIMESTONE	84	180
BROWN SANDY SHALE	180	189
WHITE SAND	189	258

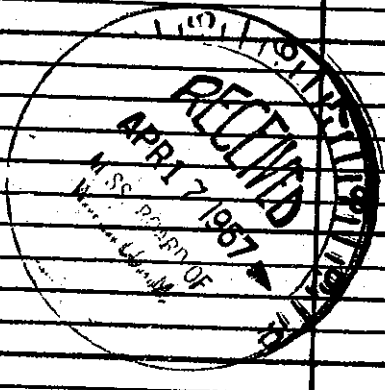

DRILLERS REMARKS: