

Clarke  
3 N11  
5-67

MISSISSIPPI  
BOARD OF WATER COMMISSIONERS  
416 North State Street  
Jackson, Mississippi 39201

P

WATER WELL DRILLERS LOG


5-30 1967 McDonald Hill CLAYKE  
date well completed firm name county well located

LANDOWNER:	description of formations encountered	from	to
TOMMY SYKES			
QUITMAN MISS. (mailing address)	BROWN SHALE SAND ST	5	37
	BROWN SHALE	37	73
	H-TAN. SHALE	73	103
	SOFT SAND & LIME	103	133
	LIME	133	160
	PEPPER SAND	160	168
	M LIME	168	175
	FINE T-M-SAND	175	220
	M-SAND	220	230

WELL LOCATION:  
sec. 5 T 2 N R 16 E  
S W  
2 1/2 miles EAST of QUITMAN  
(distance) (direction) (nearest town)

WELL PURPOSE: HOME  
(home, irrigation, municipal, industrial)

- WELL COMPLETION DATA:
- (1) diameter (inches) 2
  - (2) total depth (feet) 230
  - (3) static water level (feet) 36 below top of ground.
  - (4) casing (material) Galv. (depth) 220  
2" (size) If telescope see back.
  - (5) screen (length) 5 (depth to top) 215  
2" (size) Brass (material)
  - (6) pump 1/2 JET (HP) 10 (yield gpm)  
2 (type power)
  - (7) electric log NO (yes or no)  
NO (organization running log)
  - (8) how well bottom plugged VALVE  
BACK WASH VALVE

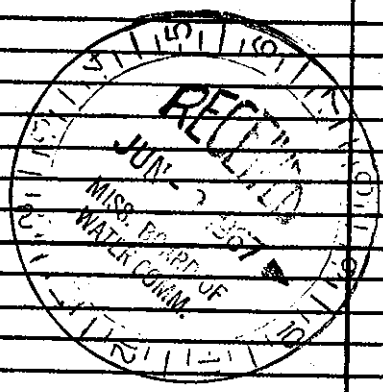

DRILLERS REMARKS: