


Clark
 S ~~13~~ N13
 11-67

MISSISSIPPI BOARD OF WATER COMMISSIONERS

WATER WELL DRILLERS LOG

Date: 11-14, 1967, Driller: McDonald + Hill County CLARK
(When well drilled) (Name) (Where well is located)

(1) Owner of Land: <u>GEORGE THOMPSON</u> <small>(Name)</small>	Description & Color of Materials Sand, Clay, Red Clay, Shell, etc.	Thick- ness Feet	Depth Feet
<u>DESOTO MISS</u> <small>(Address)</small>	<u>CLAY</u>	<u>0</u>	<u>8</u>
(2) Location: <u>1/4</u> , <u>1/4</u> , Sec. <u>32 T2 R6</u>	<u>SAND</u>	<u>8</u>	<u>17</u>
<u>3</u> miles <u>EAST</u> , of <u>DESOTO</u> <small>(distance) (direction) (Nearest Town)</small>	<u>SHALE</u>	<u>17</u>	<u>110</u>
(3) Topography: <u>X</u> <small>(Hilly) (Flat) (Level)</small>	<u>BROWN SHALE</u>	<u>110</u>	<u>135</u>
(4) Purpose of Well: <u>DOMESTIC</u> <small>(Domestic Irrigation Municipal, Industrial, Other)</small>	<u>BROWN SAND</u>	<u>135</u>	<u>200</u>
Information upon completion of well:	<u>SAND No 12</u>	<u>220</u>	<u>220</u>
(1) Diameter <u>2"</u> inches. <u>WELL</u>			
(2) Total Depth <u>220'</u> feet.			
(3) Water Level <u>48'</u> feet below top of ground.			
(4) Cased to <u>210</u> , Size <u>2"</u>			
(5) Screen: Size <u>2"</u> , Length <u>6'</u>			
(6) Were any formations sealed against pollution? <u>no</u> , <u>X</u> yes.			
If YES depth of formation _____			
Why _____			
Drillers Remarks: _____			
Yield in gpm: <u>10'</u>			
Size pump: <u>3/4 HP JET</u>			
Type power: <u>115'</u>			

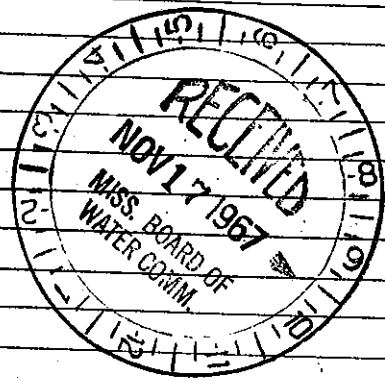

Mail this copy to Board of Water Commissioners 429 Miss. St. Jackson, Miss.