

CLARKE

MISSISSIPPI BOARD OF WATER COMMISSIONERS

6 N22
9-64

WATER WELL DRILLERS LOG

P

Date: Sept, 1964, Driller: Reefer Pullin County Clarke
(Name)

(1) Owner of Land: <u>Davis</u> (Name) <u>Quitman, Miss</u> (Address)	Description & Color of Materials Sand, Clay, Red Clay, Shell, etc.	Thick- ness Feet	Depth Feet
(2) Location: $\frac{1}{4}$, $\frac{1}{4}$, Sec. <u>12</u> , T. <u>2</u> , R. <u>16</u> <u>6</u> miles <u>E</u> , of <u>Quitman</u> (distance) (direction) (Nearest Town)	<u>Yellow sandy clay</u>		
(3) Topography: <u>Hilly</u> (Hilly) (Flat) (Level)	<u>1/2 Sand</u>	<u>31</u>	<u>31</u>
(4) Purpose of Well: <u>Home</u> (Domestic Irrigation Municipal, Industrial, Other)	<u>Blue shale</u>	<u>11</u>	<u>42</u>
	<u>Gray sand & shale</u>		
	<u>shale</u>	<u>42</u>	<u>84</u>
	<u>Blue shale</u>	<u>42</u>	<u>126</u>
	<u>White limestone</u>		
	<u>limestone</u>	<u>94</u>	<u>220</u>
	<u>brown shale &</u>		
	<u>sandy shale</u>	<u>42</u>	<u>262</u>
	<u>bluish sand &</u>		
	<u>shale streak</u>	<u>21</u>	<u>283</u>
	<u>white sand</u>	<u>32</u>	<u>315</u>


Information upon completion of well:

- (1) Diameter 2 inches.
- (2) Total Depth 315 feet.
- (3) Water Level 90 feet below top of ground.
- (4) Cased to 309', Size 2"
- (5) Screen: Size 2", Length 6'
- (6) Were any formations sealed against pollution?
yes, no.

If YES depth of formation _____

Why _____

Drillers Remarks: _____

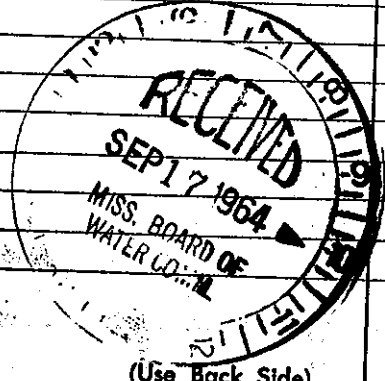

(Use Back Side)

Well No. _____

Mail this copy to Board of Water Commissioners 429 Miss. St. Jackson, Mis.