

CLARKE

MISSISSIPPI BOARD OF WATER COMMISSIONERS

6 N24
10-15-64

WATER WELL DRILLERS LOG

P

Date: 10-15, 1964, Driller: M^c Donald & Hill County _____
(Name)

(1) Owner of Land	Description & Color of Materials Sand, Clay, Red Clay, Shell, etc.	Thick- ness Feet	Depth Feet
<u>ALEX THOMPSON</u> (Name) <u>Rt. #3, Quitman</u> (Address)	<u>CLAY, ST CARL</u>	<u>0</u>	<u>30</u>
(2) Location: <u>1/4</u> , <u>1/4</u> , Sec. <u>28</u> <u>7</u> <u>16</u> T. R.	<u>SHALE</u>	<u>34</u>	<u>64</u>
<u>5</u> miles <u>S.E.</u> , of <u>Quit</u> (distance) (direction) (Nearest Town)	<u>SAND</u>	<u>40</u>	<u>50</u>
(3) Topography: <u>V</u> (Hilly) (Flat) (Level)	<u>SHALE ST ROCK</u>	<u>50</u>	<u>190</u>
(4) Purpose of Well: <u>Domestic</u> (Domestic Irrigation Municipal, Industrial, Other)	<u>SAND</u>	<u>190</u>	<u>220</u>


Information upon completion of well:

- (1) Diameter 3 7/8 inches. TEST HOLE
- (2) Total Depth 220' feet.
- (3) Water Level 90' feet below top of ground.
- (4) Cased to 210', Size 2" GALV
- (5) Screen: Size 2", Length 8' BRASS
- (6) Were any formations sealed against pollution?
_____ yes, no.

If YES depth of formation _____

Why _____

Drillers Remarks: _____

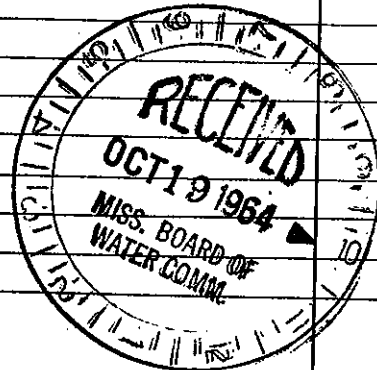

(Use Back Side)

Well No.

Mail this copy to Board of Water Commissioners 429 Miss. St. Jackson, Mis: