

ARKE MISSISSIPPI BOARD OF WATER COMMISSIONERS

P

V27

WATER WELL DRILLERS LOG

6-25-65

McDonald & Hill, Inc.

Date June 25, 1965, Driller: Roberts County: Adair

(Name)

(1) Owner of Land: M. Presley
 (Name)
Ray Quinlan, Miss.
 (Address)

(2) Location: 1/4, 1/4, Sec. 12 T. R.
6 miles East of Quinlan
 (distance) (direction) (Nearest Town)

(3) Topography: (Hilly) (Flat) (Level)

(4) Purpose of Well: Domestic
 (Domestic Irrigation
 Municipal, Industrial, Other)

Description & Color of Materials Sand, Clay, Red Clay, Shell, etc.	Thick- ness Feet	Depth Feet
Clay	0	10
Spade Sand	10	20
Fine + Shale	80	130
Sandy Lime	130	160
Med. Sand	160	175
Lime + Shale	175	192
Soft to Sandy	175	192
Shale		
med. Sand	192	200
Fine Sand	200	220
NO 12 Sand	220	231
Soft shale Fine	231	240
Sand		

Information upon completion of well:

(1) Diameter H inches.

(2) Total Depth 240 feet.

(3) Water Level 120 feet below top of ground.

(4) Cased to Bottom, Size 2"


(5) Screen: Size 2", Length 4 1/2'

(6) Were any formations sealed against pollution?
 yes, no.

If YES depth of formation _____

Why _____

Drillers Remarks: _____

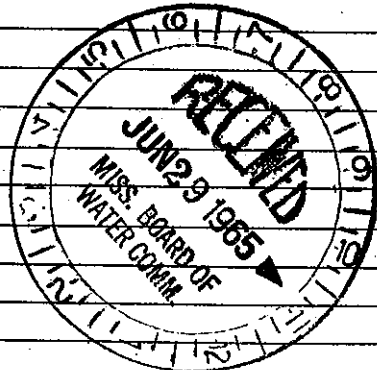

Well No.

(Use Back Side)

Mail this copy to Board of Water Commissioners 429 Miss. St. Jackson, Miss.