

CLARKE

MISSISSIPPI BOARD OF WATER COMMISSIONERS

N28


7-2-65

WATER WELL DRILLERS LOG

Date: July 2, 1965, Driller: McDonald Hill County, Clarke

(Name)

(1) Owner of Land: <u>E.A. Hallsgrubel</u> (Name)	Description & Color of Materials Sand, Clay, Red Clay, Shell, etc.	Thick- ness Feet	Depth Feet
<u>Rt #2, Quitman, Miss</u> (Address)	Clay & Sand	0	22
(2) Location: <u>1/4, 1/4, Sec. 7 2 16</u> (distance) (direction) (Nearest Town)	Brown shale	22	35
(3) Topography: <u>Hilly</u> (Hilly) (Flat) (Level)	shale & sand	35	90
(4) Purpose of Well: <u>Domestic</u> (Domestic Irrigation Municipal, Industrial, Other)	Clay sh		
Information upon completion of well:	Med shale	90	112
(1) Diameter <u>4</u> inches.	Sand shale	112	116
(2) Total Depth <u>260</u> feet.	Med shale	116	122
(3) Water Level <u>50</u> feet below top of ground.	Soft sandy loam	122	140
(4) Cased to <u>160</u> , Size <u>4</u>	Med loam	140	155
(5) Screen: Size <u>2</u> , Length <u>4</u>	Laminar shale med. 20	155	180
(6) Were any formations sealed against pollution? <u>yes</u> , <input checked="" type="checkbox"/> no.	Hard		
If YES depth of formation _____	Soft Brown shale	180	235
Why _____	Sand sh		
Drillers Remarks: _____	Med sand	235	242
_____	Shale	242	243
_____	L Sand	243	260

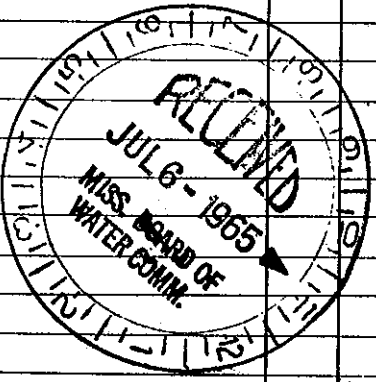

Well No.

(Use Back Side)

Mail this copy to Board of Water Commissioners 429 Miss. St. Jackson, Miss.