

ARKE MISSISSIPPI BOARD OF WATER COMMISSIONERS


11-21-63 WATER WELL DRILLERS LOG

Date: 11-21, 1963, Driller: McDonald & Hill County: Clarke
(Name)

(1) Owner of Land:	Description & Color of Materials Sand, Clay, Red Clay, Shell, etc.	Thick- ness Feet	Depth Feet
<u>Carinth Passage</u> (Name)	<u>clay</u>	<u>0</u>	<u>3</u>
<u>Rt # 2, Quitman, Miss.</u> (Address)	<u>clay</u>	<u>3</u>	<u>20</u>
(2) Location: <u>1/4, 1/4, Sec. 2 T. R.</u>	<u>shale</u>	<u>20</u>	<u>62</u>
<u>5 miles E of Quitman</u> (distance) (direction) (Nearest Town)	<u>sand</u>	<u>62</u>	<u>68</u>
(3) Topography: <u>Hilly</u> (Hilly) (Flat) (Level)	<u>shale</u>	<u>68</u>	<u>100</u>
(4) Purpose of Well: <u>Domestic</u> (Domestic Irrigation Municipal, Industrial, Other)	<u>fine sand</u>	<u>100</u>	<u>130</u>
	<u>clay</u>	<u>130</u>	<u>137</u>
	<u>fine shale</u>	<u>137</u>	<u>162</u>
	<u>shale</u>	<u>162</u>	<u>160</u>
	<u>shale</u>	<u>160</u>	<u>170</u>
	<u>fine sand</u>	<u>170</u>	<u>177</u>
	<u>sandy shale</u>	<u>177</u>	<u>180</u>
	<u>coarse sand</u>	<u>180</u>	<u>218</u>

Information upon completion of well:

- (1) Diameter: 7/8 inches.
- (2) Total Depth: 218 feet.
- (3) Water Level: 110 feet below top of ground.
- (4) Cased to: 213, Size 2"
- (5) Screen: Size 2", Length 2'
- (6) Were any formations sealed against pollution?
yes, no.

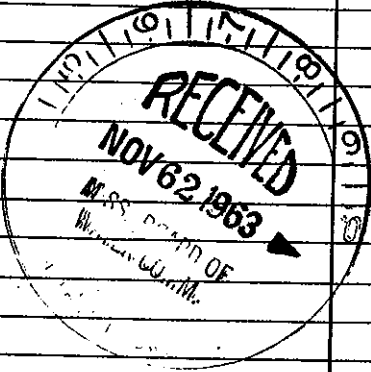

If YES depth of formation _____
Why _____
Drillers Remarks: _____

Well No. _____

(Use Back Side)

Mail this copy to Board of Water Commissioners 429 Miss. St. Jackson, Miss.