

CLARK MISSISSIPPI BOARD OF WATER COMMISSIONERS

N 33

7-3-63

WATER WELL DRILLERS LOG

Date: 7-3, 1963, Driller: McDonald & Hill County Clarke  
(Name)

(1) Owner of Land: P. H. Gable  
(Name)  
Rt. #1, Quitman, Miss  
(Address)

(2) Location: 1/4, 1/4, Sec. 10 2 16 T R  
4 miles East of Quitman  
(distance) (direction) (Nearest Town)

(3) Topography: Hilly  
(Hilly) (Flat) (Level)

(4) Purpose of Well: Domestic  
(Domestic Irrigation  
Municipal, Industrial, Other)

Description & Color of Materials Sand, Clay, Red Clay, Shell, etc.	Thick- ness Feet	Depth Feet
Clay	0	8
Shiny shale	8	43
Shale w/ thin str	43	78
Sdy shale w/ lime str	78	89
Sdy sdy shale	89	120
Sand	120	210
Sdy shale & sd	210	223
shale	223	239
shale w/ str lime	239	254
Hard sdy lime	254	260
Fine sand	260	272
Shale w/ str lime	272	320
Hard rock w/ fat sd	320	345
Shale & lime	345	380

Information upon completion of well:

(1) Diameter 3 1/4 inches.

(2) Total Depth 380 feet.

(3) Water Level 25 feet below top of ground.

(4) Cased to 235, Size 4


(5) Screen: Size \_\_\_\_\_, Length \_\_\_\_\_

(6) Were any formations sealed against pollution?  
\_\_\_\_\_ yes, \_\_\_\_\_ no.

If YES depth of formation \_\_\_\_\_

Why \_\_\_\_\_

Drillers Remarks: \_\_\_\_\_

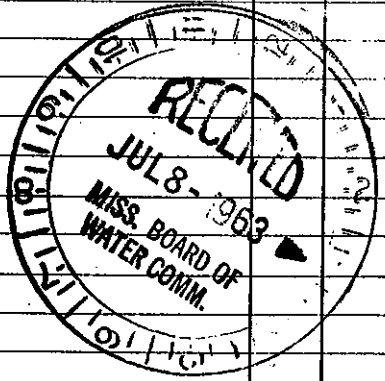

Well No.

(Use Back Side)

Mail this copy to Board of Water Commissioners 429 Miss. St. Jackson, Miss