

CLARKE MISSISSIPPI BOARD OF WATER COMMISSIONERS

5 N34

6-27-63

WATER WELL DRILLERS LOG


P

McDONALD & HILL, Inc.

Date: 6-27, 1963, Driller: P. O. Box 81 County Clarke

Meridian, Mississippi

(1) Owner of Land: <u>Abbie Fleming</u> (Name)	Description & Color of Materials Sand, Clay, Red Clay, Shell, etc.	Thick- ness Feet	Depth Feet
(Address)	Clay	0	17
(2) Location: <u>1/4, 1/4, Sec. 4 2 16</u> T R	Shale	17	40
<u>3</u> miles <u>East</u> , of <u>Quinton</u> (distance) (direction) (Nearest Town)	Sandy Clay & soil	40	60
(3) Topography: <u>Hilly</u> (Hilly) (Flat) (Level)	Shale w/ sh. breaks	60	80
(4) Purpose of Well: <u>Domestic</u> (Domestic Irrigation Municipal, Industrial, Other)	Shale	80	105
Information upon completion of well:	Limey shale w/ some lime	105	125
(1) Diameter: <u>3 1/4</u> inches.	Hard lime rock	125	127
(2) Total Depth: <u>280</u> feet.	Limey sand & shale	127	140
(3) Water Level: <u>70</u> feet below top of ground.	Limey sand	140	155
(4) Cased to: <u>125</u> , Size <u>4</u>	Sdy limey shale	155	162
(5) Screen: Size <u>2"</u> , Length <u>0'</u>	Limey shale & lime	162	195
(6) Were any formations sealed against pollution? _____ yes, _____ no.	Limey shale	185	195
If YES depth of formation _____	Sdy shale	195	210
Why _____	sd -	210	280
Drillers' Remarks: _____			

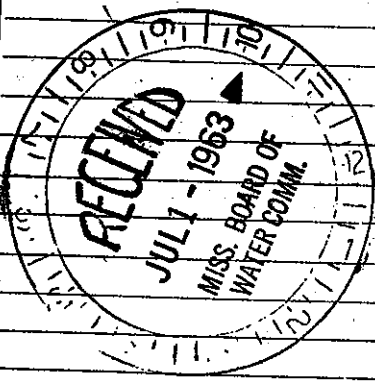

Well No.

Retain this copy for your office files.

(Use Back Side)