


OF WATER COMMISSIONERS

**CLARKE**  
WATER WELL DRILLERS LOG

N 37  
9-62

Date: Sept, 1962, Driller: Peepers & Rutledge County Clarke  
(Name)

(1) Owner of Land: <u>Mrs Dew</u> (Name)	Description & Color of Materials Sand, Clay, Red Clay, Shell, etc.	Thick- ness Feet	Depth Feet
<u>Quitman Miss</u> (Address)	<u>top to yellow sand</u>	<u>35</u>	<u>35</u>
(2) Location: <u>1/4, 2 1/6</u> <u>1/4, Sec. 11 T. R.</u>	<u>Blue shale</u>	<u>35</u>	<u>70</u>
<u>5 miles E</u> of <u>Quitman</u> (distance) (direction) (Nearest Town)	<u>Green lime + limestone</u>	<u>66</u>	<u>136</u>
(3) Topography: <u>Hilly</u> (Hilly) (Flat) (Level)	<u>shale &amp; sandy shale (gray)</u>	<u>29</u>	<u>165</u>
(4) Purpose of Well: <u>Domestic</u> (Domestic Irrigation Municipal, Industrial, Other)	<u>White sand &amp; sandrock</u>	<u>57</u>	<u>216</u>
Information upon completion of well:			
(1) Diameter <u>2</u> inches.			
(2) Total Depth <u>216</u> feet.			
(3) Water Level <u>115</u> feet below top of ground.			
(4) Cased to <u>210</u> , Size <u>2"</u>			
(5) Screen: Size <u>2"</u> , Length <u>4'</u>			
(6) Were any formations sealed against pollution?			
<u>yes</u> , <input checked="" type="checkbox"/> <u>no</u> .			
If YES depth of formation _____			
Why _____			
Drillers Remarks: _____			

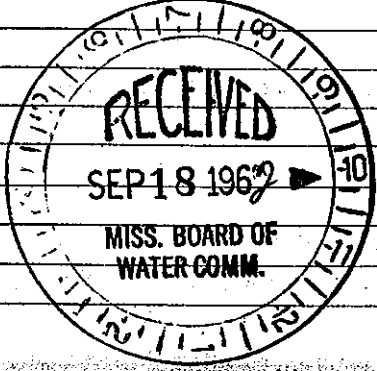

(Use Back Side)

Well No. \_\_\_\_\_

Mail this copy to Board of Water Commissioners 429 Miss. St. Jackson, Miss