

CLARKE MISSISSIPPI BOARD OF WATER COMMISSIONERS

N40

5-10-62

WATER WELL DRILLERS LOG

Date: 5-10, 1962, Driller: Mr. Donald J. Hill County Lauderdale
(Name)

(1) Owner of Land: <u>U.B. Burklin</u> (Name)	Description & Color of Materials Sand, Clay, Red Clay, Shell, etc.	Thick- ness Feet	Depth Feet
<u>Rt #3, Quitman, Miss</u> (Address)	Clay	0	10
2 16	Sandy clay	10	20
(2) Location: <u>1/4</u> , <u>1/4</u> , Sec. <u>2</u> T. <u>R.</u>	Shale	20	40
<u>5</u> miles <u>East</u> of <u>Quitman</u> (distance) (direction) (Nearest Town)	Sand & st. clay	40	80
(3) Topography: <input checked="" type="checkbox"/> (Hilly) <input type="checkbox"/> (Flat) <input type="checkbox"/> (Level)	Sand	70	150
(4) Purpose of Well: <u>Domestic</u> (Domestic Irrigation Municipal, Industrial, Other)	Shale	90	140
	Sandy shale	140	160
	shells & st. shale	160	170
	Shale	170	210
	Sand	210	225

Information upon completion of well:

(1) Diameter 2 inches.

(2) Total Depth 225 feet.

(3) Water Level 42 feet below top of ground.

(4) Cased to 220, Size 2


(5) Screen: Size 2", Length 5

(6) Were any formations sealed against pollution?
 yes, no.

If YES depth of formation _____

Why _____

Drillers Remarks: _____

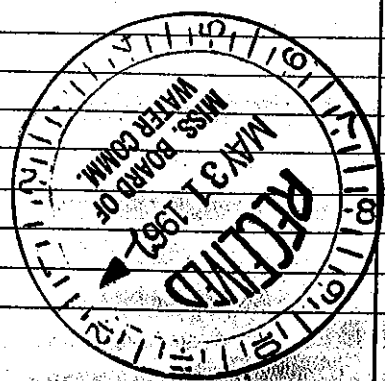

(Use Back Side)

Well No.

Mail this copy to Board of Water Commissioners 429 Miss. St. Jackson, Miss.