

N 245  
6-23-64

WATER WELL DRILLERS LOG

Date: 6-23, 1964, Driller: M. McDonald Hill Inc. County: Clarke

(Name)

(1) Owner of Land: <u>Rosevelt Evans</u> (Name)	Description & Color of Materials Sand, Clay, Red Clay, Shell, etc.	Thick- ness Feet	Depth Feet
<u>Rt #3, Quitman, Miss</u> (Address)	<u>Clay</u>	<u>0</u>	<u>10</u>
(2) Location: <u>1/4, 1/4, Sec. 11</u> T R	<u>Sand</u>	<u>10</u>	<u>18</u>
<u>5</u> miles <u>East</u> , of <u>Quitman</u> (distance) (direction) (Nearest Town)	<u>Shale</u>	<u>18</u>	<u>125</u>
(3) Topography: <input checked="" type="checkbox"/> (Hilly) <input type="checkbox"/> (Flat) <input type="checkbox"/> (Level)	<u>Sand</u>	<u>125</u>	<u>144</u>
(4) Purpose of Well: <u>Domestic</u> (Domestic Irrigation Municipal, Industrial, Other)			


Information upon completion of well:

- (1) Diameter 2" inches.
- (2) Total Depth 144 feet.
- (3) Water Level 40 feet below top of ground.
- (4) Cased to 139, Size 2"
- (5) Screen: Size 2", Length 5'
- (6) Were any formations sealed against pollution?  
no

If YES depth of formation \_\_\_\_\_

Why \_\_\_\_\_

Drillers Remarks: \_\_\_\_\_

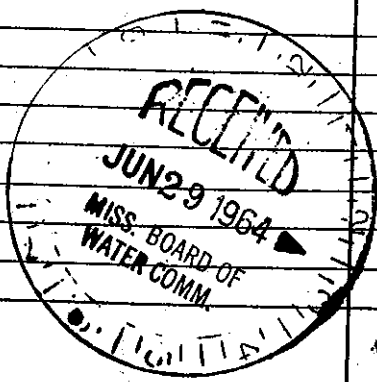

(Use Back Side)

Mail this copy to Board of Water Commissioners 429 Miss. St. Jackson,