

Clarke
N 51

MISSISSIPPI BOARD OF WATER COMMISSIONERS

WATER WELL DRILLERS LOG

Clarke

10-3-62

Date: 10-3, 1962, Driller: McDONALD & HILL, Clinton

(Ramp). Box

(1) Owner of Land	Description & Color of Material	Thickness Feet	Depth Feet
Annie Strickland (Name) Rt # 3 Quitman (Address)	Clay	0	12
	Sandy	12	16
(2) Location: 1/4, 2 1/4, Sec. 2 ^N 16 ^E T R	B. shale	16	118
6 miles SE of Quitman (distance) (direction) (Nearest Town)	fine sand	118	147
	#8 sand	147	175
(3) Topography: <input checked="" type="checkbox"/> (Hilly) <input type="checkbox"/> (Flat) <input type="checkbox"/> (Level)			
(4) Purpose of Well: Domestic (Domestic Irrigation, Municipal, Industrial, Other)			

COPIED

Information upon completion of well:

(1) Diameter 2 inches

(2) Total Depth 175 feet


(3) Water Level 35 feet below top of ground

(4) Cased to 168, Size 2

(5) Screen: Size Steel, Length 3

(6) Were any formations sealed against pollution?
yes, no.

COPIED

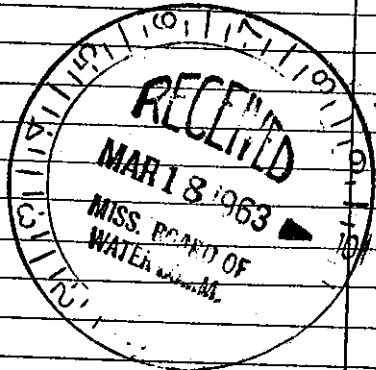

If YES, depth of formation

Why

Drillers Remarks:

Well No.

(Use Back Side)

Mail this copy to Board of Water Commissioners 429 Miss. St. Jackson, Miss.