

AUG 11 1962

WATER WELL DRILLERS LOG

Date: August 10, 1962, Driller: (P) A. V. Thornton County Clarke
(Name)

501
8-10-62

	Description & Color of Materials Sand, Clay, Red Clay, Shell, etc.	Thick- ness Feet	Depth Feet
(1) Owner of Land: J. E. Long (Name) Rte 2 - Quitman, Miss. (Address)	Top soil & shale		35'
	Shale & fine sand		200'
	Sand		231'
(2) Location: N 1/4, W 1/4, Sec. 17, T2N, R17E _____ miles _____ of _____ (distance) (direction) (Nearest Town)			
(3) Topography: Hilly (Hilly) (Flat) (Level)			
(4) Purpose of Well: Domestic (Domestic Irrigation Municipal, Industrial, Other)			

Information upon completion of well:

(1) Diameter 2 inches.

(2) Total Depth 231 feet.

(3) Water Level 130 feet below top of ground.

(4) Cased to 231', Size 2"


(5) Screen: Size None, Length _____.

(6) Were any formations sealed against pollution?
_____ yes, X no.

If YES depth of formation _____

Why _____

Drillers Remarks: None

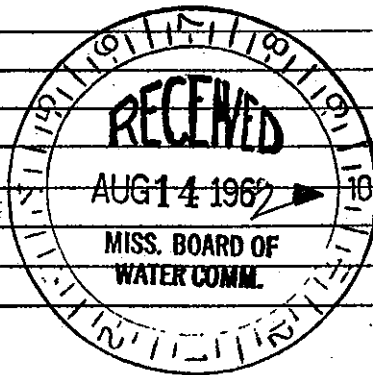

(Use Back Side)

Well No.

Mail this copy to Board of Water Commissioners 429 Miss. St. Jackson, Miss.