

CLARKE


MISSISSIPPI BOARD OF WATER COMMISSIONERS

502
2-65

WATER WELL DRILLERS LOG

Date: Feb, 1945, Driller: Peoples Drilling Co County, Clarke
(Name)

(1) Owner of Land:	Description & Color of Materials Sand, Clay, Red Clay, Shell, etc.	Thick- ness Feet	Depth Feet
(Name) Tindler (Address) Quitman, Miss	yellow sandy clay	15	15
(2) Location: 1/4, 1/4, Sec. 31 T. 2 R. 17	blue marl	55	70
(distance) 2 miles (direction) N, of (Nearest Town) Cornsuck	green lined shale	12	82
(3) Topography: Hilly (Hilly) (Flat) (Level)	green lined + limestone	68	150
(4) Purpose of Well: Home (Domestic Irrigation Municipal, Industrial, Other)	gray sandy shale	10	160
Information upon completion of well:	white sand	35	195
(1) Diameter 2 inches.			
(2) Total Depth 195 feet.			
(3) Water Level 95 feet below top of ground.			
(4) Cased to 189', Size 2"			
(5) Screen: Size 2', Length 6'			
(6) Were any formations sealed against pollution? yes, no.			
If YES depth of formation			
Why			
Drillers Remarks:			

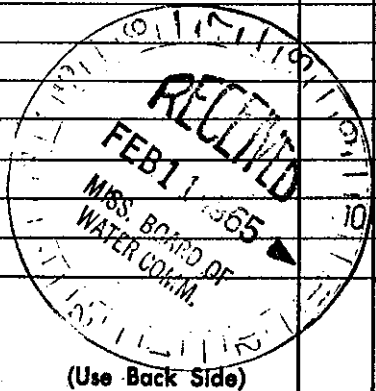

Well No.

Mail this copy to Board of Water Commissioners 429 Miss. St. Jackson, Miss.