

CLARKE MISSISSIPPI BOARD OF WATER COMMISSIONERS

303  
5-66

WATER WELL DRILLERS LOG

Date: May, 1966, Driller: Peoples Drilling Co County Clarke  
(Name)


(1) Owner of Land: James Gibson  
(Name)  
Rt 4 Quitman, Miss.  
(Address)  
Community of Crandall  
(2) Location: 1/4, 1/4, Sec. 34 T2 R17  
Crandall  
miles \_\_\_\_\_ of \_\_\_\_\_  
(distance) (direction) (Nearest Town)  
(3) Topography: Flat  
(Hilly) (Flat) (Level)  
(4) Purpose of Well: Home  
(Domestic Irrigation  
Municipal, Industrial, Other)

Description & Color of Materials Sand, Clay, Red Clay, Shell, etc.	Thick- ness Feet	Depth Feet
<u>Yellow sandy clay</u>	<u>15</u>	<u>15</u>
<u>Yellow Sand</u>	<u>4</u>	<u>19</u>
<u>Gray shale</u>	<u>19</u>	<u>38</u>
<u>Thin limestone</u>	<u>82</u>	<u>120</u>
<u>Sandy shale (gray)</u>	<u>66</u>	<u>186</u>
<u>Brown sandy shale</u>	<u>42</u>	<u>228</u>
<u>White Sand &amp; Brown shale streaks</u>	<u>27</u>	<u>255</u>

Information upon completion of well:

(1) Diameter 2 inches.  
(2) Total Depth 195 feet.  
(3) Water Level 20 feet below top of ground.  
(4) Cased to 189', Size 2"  
(5) Screen: Size 2", Length 6'  
(6) Were any formations sealed against pollution?  
\_\_\_\_\_ yes, \_\_\_\_\_ no.

If YES depth of formation \_\_\_\_\_  
Why \_\_\_\_\_  
Drillers Remarks: \_\_\_\_\_

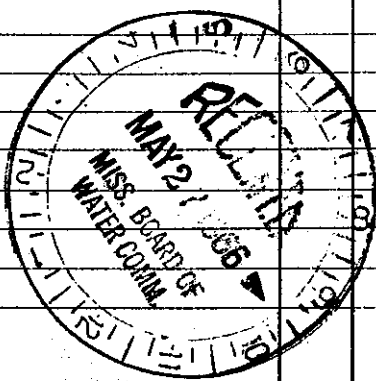

Well No.

(Use Back Side)

Mail this copy to Board of Water Commissioners 429 Miss. St. Jackson, Miss.