

CLARKE

MISSISSIPPI BOARD OF WATER COMMISSIONERS

WATER WELL DRILLERS LOG

4-17-61

Date: 4-17, 1961, Driller: M. E. Donald & H. W. Dale County: Clarke

(Name)

(1) Owner of Land: Arnold Tindle  
(Name)  
Rt. # 4, Quitman, Miss.  
(Address)

(2) Location: 1/4, 1/4, Sec. 28 T 18 R 18  
18 miles East of Quitman.  
(distance) (direction) (Nearest Town)

(3) Topography: Hilly  
(Hilly) (Flat) (Level)

(4) Purpose of Well: Domestic  
(Domestic Irrigation, Municipal, Industrial, Other)

Description & Color of Materials Sand, Clay, Red Clay, Shell, etc.	Thick- ness Feet	Depth Feet
Clay	0	12
Sand	12	21
Shale	21	62
Sandy Shale	62	69
Cavity	69	71
Shale	71	73
Cavity	73	75
Fine Sand	75	90
Sandy Shale	90	107
Sandy Lime	107	120
Sandy marl	120	140
Fine Sand	140	160
Shale	160	180
Fine Sand.	180	190
Sand	190	200
Coarse Sand	200	230

Information upon completion of well:

(1) Diameter 3 inches.

(2) Total Depth 230 feet.

(3) Water Level 176 feet below top of ground.

(4) Cased to 228, Size 2"


(5) Screen: Size 2", Length 6'

(6) Were any formations sealed against pollution?  
yes,  no.

If YES depth of formation \_\_\_\_\_

Why \_\_\_\_\_

Drillers Remarks: \_\_\_\_\_

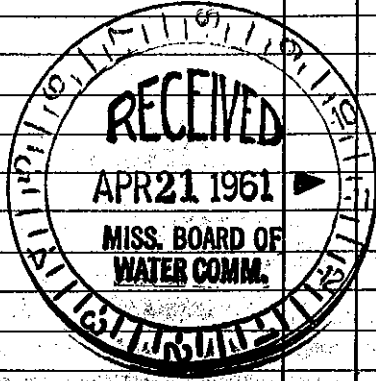

(Use Back Side)

Well No.

Mail this copy to Board of Water Commissioners 429 Miss. St. Jackson, Miss.