

MISSISSIPPI BOARD OF WATER COMMISSIONERS

CLARKE

08

9-13-61

WATER WELL DRILLERS LOG

Date: 9, 13, 1961, Driller McDONALD HILL County CLARKE

(Name)

(1) Owner of Land: BILL CAMERON
 (Name)
R# 4 QUITMAN
 (Address)

(2) Location: 1/4, 1/4, Sec. 28 2 18
 (distance) (direction) (Nearest Town)

20 miles EAST of QUITMAN
 (distance) (direction) (Nearest Town)

(3) Topography: X
 (Hilly) (Flat) (Level)

(4) Purpose of Well: DOMESTIC
 (Domestic Irrigation
 Municipal, Industrial, Other)

| Description & Color of Materials Sand, Clay, Red Clay, Shell, etc. | Thick- ness Feet | Depth Feet |
|---|------------------------|---------------|
| CLAY | 0 | 20 |
| SAND | 20 | 52 |
| BLUE SHALE | 52 | 70 |
| SANDY LIME | 70 | 100 |
| SHALE ST ROCK | 100 | 190 |
| SAND SHALE | 190 | 200 |
| SANDY SHALE | 200 | 225 |
| SAND | 225 | 244 |

Information upon completion of well:

(1) Diameter 3 1/4 inches.

(2) Total Depth 240' feet.

(3) Water Level 135' feet below top of ground.

(4) Cased to 231', Size 2'


(5) Screen: Size 2", Length 6'

(6) Were any formations sealed against pollution?
 _____ yes, _____ no.

If YES depth of formation _____

Why _____

Drillers Remarks: _____

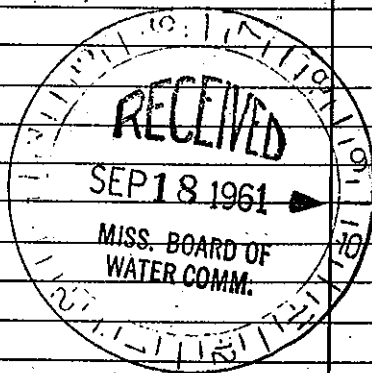

Well No.

(Use Back Side)

Mail this copy to Board of Water Commissioners 429 Miss. St. Jackson, Miss.