

CLARKE MISSISSIPPI BOARD OF WATER COMMISSIONERS

010

9-3-63

WATER WELL DRILLERS LOG

Date: 9-3, 1963, Driller: me Donald & Hill County Clarke  
(Name)

(1) Owner of Land: <u>J J Ream</u> (Name)	Description & Color of Materials Sand, Clay, Red Clay, Shell, etc.	Thick- ness Feet	Depth Feet
<u>Rt #4, Gautman, miss</u> (Address)	Clay	0	17
(2) Location: <u>1/4, 1/4, Sec. 11 T 17 R 17</u>	Sd.	17	26
<u>12 miles East</u> , of <u>Gautman</u> (distance) (direction) (Nearest Town)	Silty Clay & Sd	26	43
(3) Topography: <u>Hilly</u> (Hilly) (Flat) (Level)	Shale w/ sd. streaks	43	60
(4) Purpose of Well: <u>Domestic</u> (Domestic Irrigation Municipal, Industrial, Other)	Shale <del>streaks</del>	60	92
	Silty shale	92	122
	Sand - silty shale	122	143
	shale w/ sd. str.	143	160
	shale w/ lime & sd.	160	180
	Red shale	180	190
	Sd	190	220


Information upon completion of well:

- (1) Diameter 3 7/8 inches.
- (2) Total Depth 220 feet.
- (3) Water Level 100 feet below top of ground.
- (4) Cased to 219, Size 4 + 2.
- (5) Screen: Size 2", Length 6'.
- (6) Were any formations sealed against pollution?  
\_\_\_\_\_ yes, \_\_\_\_\_ no.

If YES depth of formation \_\_\_\_\_

Why \_\_\_\_\_

Drillers Remarks: \_\_\_\_\_

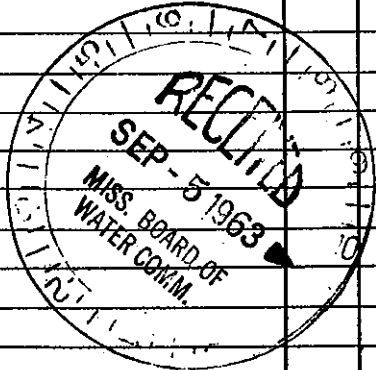

Well No.

(Use Back Side)

Mail this copy to Board of Water Commissioners 429 Miss. St. Jackson, Miss.