

**CLARKE MISSISSIPPI BOARD OF WATER COMMISSIONERS**

10-25-63

**WATER WELL DRILLERS LOG**

2 P

Date: 10-25, 1963, Driller: me Donald & Hill County Clarke  
(Name)

(1) Owner of Land	Description & Color of Materials Sand, Clay, Red Clay, Shell, etc.	Thick- ness Feet	Depth Feet
<u>Raymond Mc Pee</u> (Name) <u>RT #4, Qu. Henry, Miss</u> (Address)	<u>oldy. clay &amp; sand</u>	<u>0</u>	<u>19</u>
(2) Location: <u>1/4</u> , <u>1/4</u> , Sec. <u>27</u> T <u>2</u> R <u>17</u>	<u>shale</u>	<u>14</u>	<u>25</u>
<u>12</u> miles <u>E</u> of <u>Quitman</u> (distance) (direction) (Nearest Town)	<u>shale w/ shale str.</u>	<u>20</u>	<u>45</u>
(3) Topography: <u>Hilly</u> (Hilly) (Flat) (Level)	<u>shale</u>	<u>45</u>	<u>90</u>
(4) Purpose of Well: <u>Domestic</u> (Domestic Irrigation Municipal, Industrial, Other)	<u>shale w/ lime str.</u>	<u>90</u>	<u>105</u>
	<u>limy shale</u>	<u>105</u>	<u>125</u>
	<u>limy shale sand</u>	<u>125</u>	<u>150</u>
	<u>limy shale</u>	<u>150</u>	<u>180</u>
	<u>fine sand</u>	<u>180</u>	<u>200</u>
	<u>Red shale</u>	<u>200</u>	<u>215</u>
	<u>Coarse sand</u>	<u>215</u>	<u>236</u>


Information upon completion of well:

- (1) Diameter 3 7/8 inches.
- (2) Total Depth 236 feet.
- (3) Water Level 80 feet below top of ground.
- (4) Cased to 231, Size 4x2.
- (5) Screen: Size 2", Length 0'.
- (6) Were any formations sealed against pollution?  
\_\_\_\_\_ yes, \_\_\_\_\_ no.

If YES depth of formation \_\_\_\_\_

Why \_\_\_\_\_

Drillers Remarks: \_\_\_\_\_

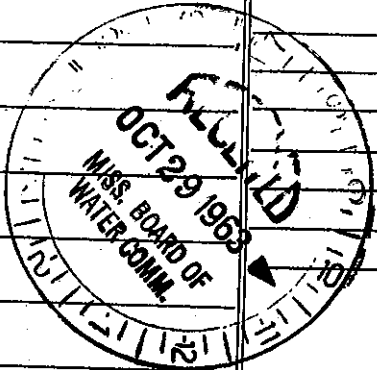

2

Well No. 123

(Use Back Side)

Mail this copy to Board of Water Commissioners 429 Miss. St. Jackson, Miss.