

6013
11-29-63

WATER WELL DRILLERS LOG

Date: 11-29, 1963, Driller: Holly Overstreet County Clerk
(Name)

(1) Owner of Land:	Description & Color of Materials Sand, Clay, Red Clay, Shell, etc.	Thick- ness Feet	Depth Feet
Herman Carmichael (Name) Crandall, Miss. (Address)	yellow sand	0	30
(2) Location: 1/4, 1/4, Sec. 26 T. 2 R. 18	Soft Sand & Shale	30	120
18 miles East of Quitman (distance) (direction) (Nearest Town)	hard formation	120	180
(3) Topography:	Sand	180	200
(Hilly) (Flat) (Level)			
(4) Purpose of Well: Domestic (Domestic Irrigation Municipal, Industrial, Other)			


Information upon completion of well:

- (1) Diameter 3" inches.
- (2) Total Depth 200 feet.
- (3) Water Level 21' feet below top of ground.
- (4) Cased to 126', Size 3"
- (5) Screen: Size 2", Length 6'
- (6) Were any formations sealed against pollution?
 yes, no.

If YES depth of formation 126'

Why Soft formation

Drillers Remarks:
good sand at 180-200'

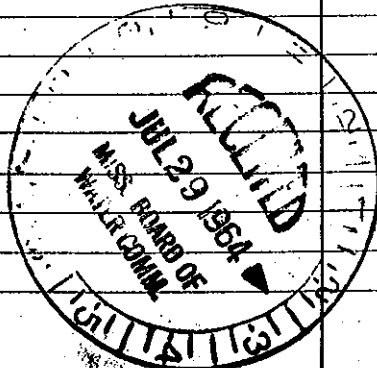

(Use Back Side)

Well No.