

CLARKE MISSISSIPPI BOARD OF WATER COMMISSIONERS

6014

2-17-64 WATER WELL DRILLERS LOG

CODED P

Date: 2-17, 1964, Driller: McDonald & Hill County Clarke

(Name)

	Description & Color of Materials Sand, Clay, Red Clay, Shell, etc.	Thick- ness Feet	Depth Feet
(1) Owner of Land: <u>Providence Methodist Church</u> (Name)	Clay	0	18
<u>Rt #4 Quitman, MS</u> (Address)	Sand	18	20
(2) Location: <u>1/4, 1/4, Sec. 35 T. 2 N.</u>	Clay	20	20
<u>1.5 miles East</u> of <u>Quitman</u> (distance) (direction) (Nearest Town)	Sand	20	30
(3) Topography: <u>Hilly</u> (Hilly) (Flat) (Level)	Shale	35	96
(4) Purpose of Well: <u>Domestic</u> (Domestic Irrigation Municipal, Industrial, Other)	Sandy shale & lime	96	110
	Sandy shale	115	140
	Sand & sandy shale	140	187
	Shale	187	220
	Sandy shale & lime	220	240

Information upon completion of well:


- (1) Diameter 4 inches.
- (2) Total Depth 240 feet.
- (3) Water Level 105 feet below top of ground.
- (4) Cased to 116, Size 4
- (5) Screen: Size \_\_\_\_\_, Length \_\_\_\_\_
- (6) Were any formations sealed against pollution?  
\_\_\_\_\_ yes, \_\_\_\_\_ no.

If YES depth of formation \_\_\_\_\_

Why \_\_\_\_\_

Drillers Remarks: Lost Circulation

Q 237 in line

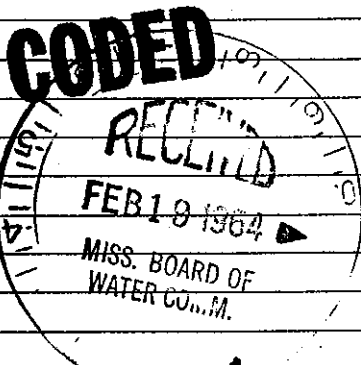

(Use Back Side)

Well No.

Mail this copy to Board of Water Commissioners 429 Miss. St. Jackson, Miss.