


CLARKE MISSISSIPPI BOARD OF WATER COMMISSIONERS

N 017
9-5-63

WATER WELL DRILLERS LOG

Date: 9-5, 1963, Driller: Donald Clarke
(Name)

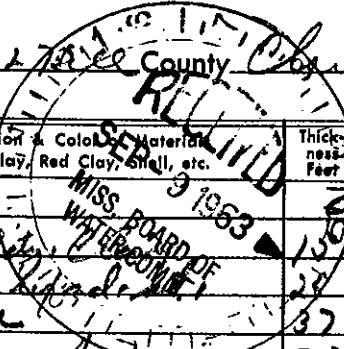

(1) Owner of Land:	Description & Color of Waterfall Sand, Clay, Red Clay, Shell, etc.	Thickness Feet	Depth Feet
J. M. Fard (Name) Rt. #4, Quitman (Address)	Clay	0	10
(2) Location: 1/4, 1/4, Sec. 4 T. 11 R.	Shale	150	29
9 miles East of Quitman (distance) (direction) (Nearest Town)	Shale	27	37
(3) Topography: Hilly (Hilly) (Flat) (Level)	Sandy shale	70	110
(4) Purpose of Well: Domestic (Domestic Irrigation Municipal, Industrial, Other)	Sand	110	124
	Sandy shale	124	160
	Sand	160	240

Information upon completion of well:

- (1) Diameter 3 7/8 inches.
- (2) Total Depth 240 feet.
- (3) Water Level 85 feet below top of ground.
- (4) Cased to 233, Size 4 L 2.
- (5) Screen: Size 2", Length 6'.
- (6) Were any formations sealed against pollution?
_____ yes, _____ no.

If YES depth of formation _____

Why _____

Drillers Remarks: _____

Well No.

(Use Back Side)

Mail this copy to Board of Water Commissioners 429 Miss. St. Jackson, Miss.