

CLARKE

WATER WELL DRILLERS LOG

Date: 4-5-66, 1966, Driller: M. D. DONAHUE & HILL, INC. County _____

(Name)

(1) Owner of Land:	Description & Color of Materials Sand, Clay, Red Clay, Shell, etc.	Thick- ness Feet	Depth Feet
<u>HOWARD HUNTER</u> (Name)	<u>CLAY</u>	<u>0</u>	<u>10</u>
<u>QUITMAN MISS</u> (Address)	<u>SAND CLAY</u>	<u>10</u>	<u>23</u>
(2) Location: <u>1/4</u> , <u>1/4</u> , Sec <u>1</u> <u>2</u> <u>17</u> T <u>1</u> R <u>17</u>	<u>SHALE</u>	<u>23</u>	<u>70</u>
<u>12</u> miles <u>EAST</u> , of <u>QUITMAN</u> (distance) (direction) (Nearest Town)	<u>SOFT SHALE</u>	<u>70</u>	<u>85</u>
(3) Topography: <u>X</u> (Hilly) (Flat) (Level)	<u>SANDY SHALE ST SAND</u>	<u>85</u>	<u>130</u>
(4) Purpose of Well: <u>DOMESTIC</u> (Domestic Irrigation Municipal, Industrial, Other)	<u>SHALE</u>	<u>130</u>	<u>150</u>

Information upon completion of well:

(1) Diameter 3 7/8 inches. TEST HOLE

(2) Total Depth 150' feet.

(3) Water Level 70' feet below top of ground.

(4) Cased to 63', Size 4"


(5) Screen: Size _____, Length _____

(6) Were any formations sealed against pollution?
_____ yes, X no.

If YES depth of formation _____

Why _____

Drillers Remarks: _____

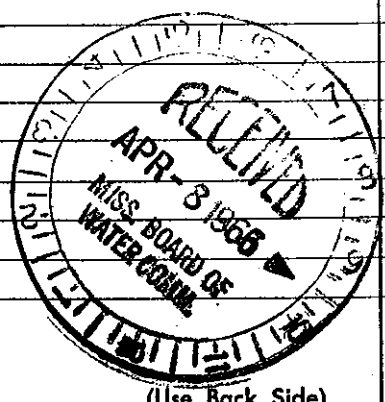

(Use Back Side)

Well No.

Mail this copy to Board of Water Commissioners 429 Miss. St. Jackson, Miss