

TERS

WELL DRILLERS LOG

Clarke

Date: 5-19, 1961, Driller: M^{rs} Donald + Hill County ~~headville~~ ^{CLARKE}

(Name)

(1) Owner of Land Conway Drilling Co.
(Name)
Headville, Miss.
(Address)
(2) Location: 24 2N, 7E
15 miles Southeast of Quitman
(distance) (direction) (Nearest Town)
(3) Topography: (Level)
(4) Purpose of Well: Domestic
(Domestic Irrigation, Municipal, Industrial, Other)

Description & Color of Materials Sand, Clay, Red Clay, Shell	Thick- ness Feet	Depth Feet
Sandy Clay	0	10
Clay	10	20
Lime	20	23
Shale	23	30
Sand	30	38
Shale	38	76
Sandy shale	76	125
Fine Sandy Shale	125	140
Fine Sand	140	164
Sand No. 8	164	170

CODED


Information upon completion of well:

- (1) Diameter 2 inches.
 (2) Total Depth 172 feet.
 (3) Water Level 37 feet below top of ground.
 (4) Cased to 78, Size 2"
 (5) Screen: Size 2", Length 5'
 (6) Were any formations sealed against pollution?
 _____ yes, no.

If YES depth of formation _____

Why _____

Drillers Remarks: _____

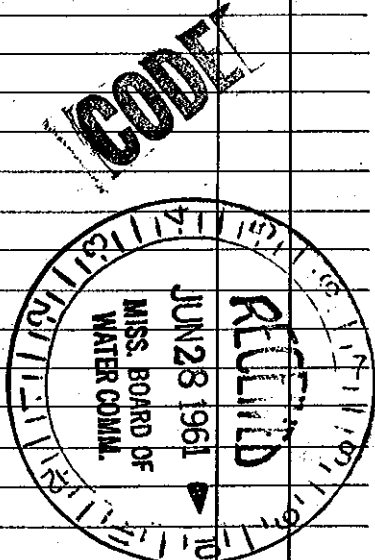

Well No.

(Use Back Side)

Mail this copy to Board of Water Commissioners 429 Miss. St. Jackson, Miss.