

# State Well Report

## Part 1

Mississippi Department of Environmental Quality  
Office of Land and Water Resources  
P.O. Box 10631  
Jackson, MS 39289-0631  
(601)961-5210  
(601)354-6938 (fax)

County: CLARK  
Permit #:  
Driller: McDonald & Hill  
Date drilling completed: 3-23-06

For Office Use Only:  
Aquifer: \_\_\_\_\_  
Well #: Q-42  
L. S. Elevation: \_\_\_\_\_  
E-log #: \_\_\_\_\_

State Law requires that this report be prepared by the driller in detail and filed with the Department within 30 days of completion of drilling of the well.

Well Owner Information	Well Location
Owner Name: <u>Allie Beel</u>	Latitude: _____ Longitude: _____
Mailing Address: <u>3277-CP2643</u>	Method of Lat/Long (circle one): Conventional Survey, USGS quad, Hand-held GPS, Survey-grade GPS
City: <u>Gritman, MS</u> State: <u>MS</u> Zip Code: <u>39315</u>	1/4 Sec: <u>8</u> Twn: <u>2 N</u> Rng: <u>18 E</u>
Telephone No: <u>601-776-2215</u>	Distance: <u>15</u> Miles Direction: <u>E</u> of Nearest Town: <u>Gritman</u>

**Well Data**

Purpose of Well (circle one): Home Industrial Public Supply Irrigation Fish Culture Other: \_\_\_\_\_

Date well drilling started: 3-20-06 Date well drilling completed: 3-23-06

If flowing, method of flow regulation: Valve \_\_\_\_\_ Other (describe) \_\_\_\_\_

Static Water Level: 135 feet above or below (circle one) land surface Date measured: \_\_\_\_\_

Method of Measurement (circle one): steel tape electric tape air line other: Stumpy

Hole depth: 360 Well depth: 360 Well grouted to a depth of 10 feet

Type of grout (circle one): Cement Bentonite Mix

Casing length: 210 feet Casing diameter: 4 inches Type of casing: PVC

Screen length: \_\_\_\_\_ feet Screen diameter: \_\_\_\_\_ inches Type of screen: \_\_\_\_\_

Screen slot size: \_\_\_\_\_ inches Setting depth: From \_\_\_\_\_ feet to \_\_\_\_\_ feet

Type of completion (circle all applicable): Gravel packed Underreamed Telescoped Open hole Natural Development

Other (describe): \_\_\_\_\_

Top of lap pipe or reduction in casing: \_\_\_\_\_ feet. If telescoped or more than one screen, describe on back of page

Logs run (circle all applicable): No log run Electric Gamma Ray Density Sonic Neutron Other: \_\_\_\_\_

Name of organization running log(s): \_\_\_\_\_

I certify that the well was drilled, constructed, and completed in accordance with all applicable requirements of the Mississippi Department of Environmental Quality and/or the Mississippi Department of Health regulations and state laws.


McDonald & Hill, Inc  
Print Name of Water Well Contractor and License No.

Arnold Hill  
Signature of Water Well Contractor

RECEIVED  
APR 06 2006  
BY: OLWR

Q-42


If well telescopes please sketch below and show depths.

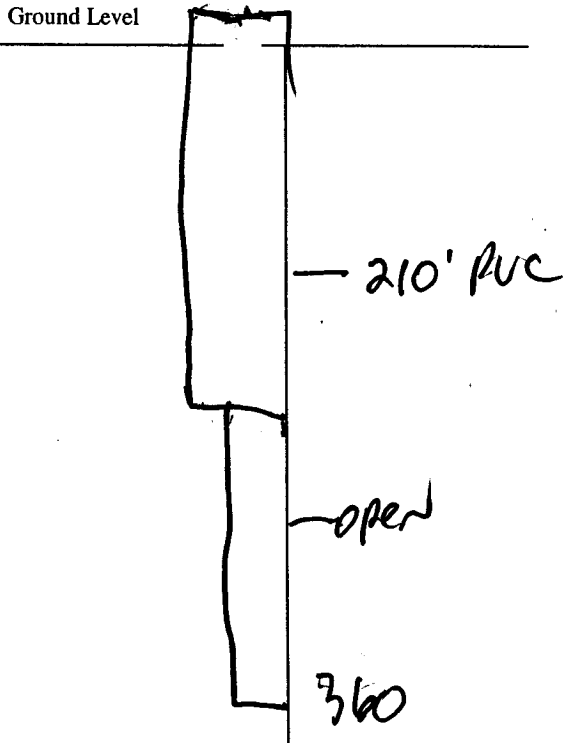

Description of Formations Encountered	From	To
Red SAND & clay	0	20
Shale	20	60
Lig st & SAND	60	120
Shale	120	150
Rock	150	151
Shale & SAND	151	190
Rock	190	192
Rocky st	192	200
Sandy shale	200	300
fine SAND	300	360

If more than one screen, show location of each on sketch

Sketch the property layout and include the following: 1) the well location; 2) any permanent structures on the property that may aid in locating the well; 3) any roads, power lines, or other items that may aid in locating the property and the well; 4) indicate direction.

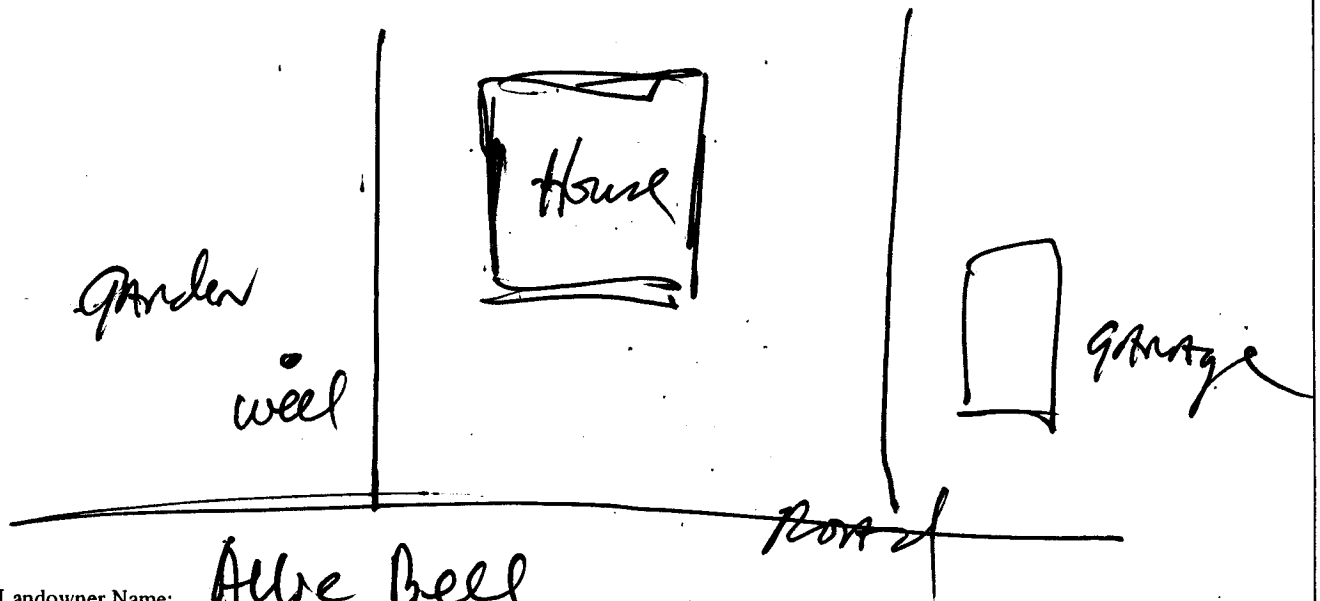

Landowner Name: Alve Bell

Harold Hill  
Signature of Water Well Contractor

RECEIVED  
APR 06 2006  
BY: OLWR

# STATE WELL REPORT

## Part 2

**Pump Installer's Completion Report**  
 Mississippi Department of Environmental Quality  
 Office of Land and Water Resources  
 P.O. Box 10631  
 Jackson, MS 39289-0631  
 (601)961-5210  
 (601)354-6938 (fax)

County: Clarks  
 Permit #: \_\_\_\_\_  
 Driller: Mr. Donald & Hill  
 Date completed: 3-30-06

**For Office Use Only:**

Aquifer: \_\_\_\_\_  
 Well #: Q-42  
 Elevation: \_\_\_\_\_

This report should be prepared by the pump installer in detail and filed with the Department within 30 days of the installation of pump.

Well Owner Information	Well Location
Owner Name: <u>Allie Beep</u>	Latitude: _____ Longitude: _____
Mailing Address: <u>3277 - CR 643</u>	Method of Lat/Long (circle one): Conventional Survey, USGS quad, Hand-held GPS, Survey-grade GPS
<u>Quitman, MS - 39355</u>	_____ 1/4 _____ 1/4 Sec <u>8</u> Twp <u>2N</u> Rng <u>18E</u>
City State Zip Code	Distance Direction Nearest Town
Telephone No. (____) _____	<u>15</u> Miles <u>E</u> of <u>Quitman</u>

Pump Type Circle one	Power Type Circle one
Air Lift Jet <input type="radio"/> <u>Submersible</u>	Diesel Engine Gasoline Engine Natural Gas
Bucket Piston <input type="radio"/> Turbine <input type="radio"/>	<u>Electric Motor</u> Hand Tractor PTO
Centrifugal Rotary <input type="radio"/> Flowing Well <input type="radio"/>	Windmill Other (specify): _____
Other (specify): _____	Horse Power Rating of Motor: <u>1/2</u>
Date Pump Installed: <u>3-30-06</u>	Setting Depth: <u>160</u> feet
Rated Pump Capacity: <u>5</u> Gallons Per Minute	Number of Stages: <u>15</u>

Pump Test Data	Method of Measuring Water Level Circle one
Date Well Tested: <u>3-30-06</u>	Air Line Electric Measuring Line Steel Tape
Static Water Level (A): <u>135</u> Feet Below Land Surface	Other (specify): <u>Stang</u>
Pumping Water Level (B): <u>145</u> Feet Below Land Surface	For flowing well, measured shut in head: _____ feet
Drawdown [(B) - (A)]: <u>10</u> Feet Below Land Surface	Well yielded <u>7</u> GPM with a drawdown of
Test Pumping Rate: <u>7</u> Gallons Per Minute	<u>10</u> feet after <u>4</u> hours of pumping
Duration of Pump Test (minimum 4 hours): <u>4</u> hours	

I HEREBY CERTIFY that the above statements are true to the best of my knowledge.

Mr. Donald & Hill, Inc # 0.8 Harold Hill  
 Print Name of Pump Installer and License No. (if applicable) Signature of Pump Installer

**RECEIVED**  
 APR 06 2006  
 BY: OLWR