

CLARKE MISSISSIPPI BOARD OF WATER COMMISSIONERS

3 PZ
4-17-63

WATER WELL DRILLERS LOG

Date: 4-17, 1963, Driller: Self Chatham County Clarke
(Name)

(1) Owner of Land:	Description & Color of Materials	Thick-ness Feet	Depth Feet
<u>West Pleasant Grove Baptist Church</u> (Name)	<u>Clay</u>	<u>0</u>	<u>12</u>
<u>70 Larkin Hill, Washington</u> (Address)	<u>Sol. Clay</u>	<u>12</u>	<u>34</u>
(2) Location: $\frac{1}{4}$, $\frac{1}{4}$, Sec. <u>8</u> T <u>14</u> R	<u>Shale w/struck line</u>	<u>34</u>	<u>165</u>
<u>3</u> miles <u>East</u> of <u>Washington</u> (distance) (direction) (Nearest Town)	<u>Thinly shell</u>	<u>165</u>	<u>175</u>
(3) Topography: <u>Flat</u> (Hilly) (Flat) (Level)	<u>Sol. brown shale</u>	<u>175</u>	<u>195</u>
(4) Purpose of Well: <u>Domestic</u> (Domestic Irrigation Municipal, Industrial, Other)	<u>Sand</u>	<u>195</u>	<u>200</u>
	<u>Sand w/shale str.</u>	<u>200</u>	<u>220</u>


Information upon completion of well:

- (1) Diameter 3 1/4 inches.
- (2) Total Depth 220 feet.
- (3) Water Level 70 feet below top of ground.
- (4) Cased to 148, Size 3"
- (5) Screen: Size _____, Length _____.
- (6) Were any formations sealed against pollution?
_____ yes, _____ no.

If YES depth of formation _____

Why _____

Drillers Remarks: _____

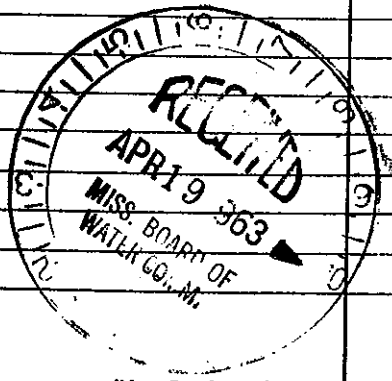

(Use Back Side)

Well No.

Mail this copy to Board of Water Commissioners 429 Miss. St. Jackson, Miss