

CLARKE

3 P5

MISSISSIPPI BOARD OF WATER COMMISSIONERS

CODED

8-10-65

WATER WELL DRILLERS LOG

Date Aug 10, 1965, Driller Porter Drilling & Pump Co., Clarke County, Clarke

(1) Owner of Land: Luvet Bonner
 (Name)
At 1 Vossberg, Miss.
 (Address)
 (2) Location: SW 1/4, SW 1/4, Sec. 31 T. 1 R. 14
5 miles east of Vossberg
 (distance) (direction) (Nearest Town)
 (3) Topography: hilly
 (Hilly) (Flat) (Level)
 (4) Purpose of Well: domestic
 (Domestic Irrigation, Municipal, Industrial, Other)


Description & Color of Materials Sand, Clay, Red Clay, Shell, etc.	Thick- ness Feet	Depth Feet
<u>red clay</u>	<u>12</u>	<u>12</u>
<u>red sand</u>	<u>6</u>	<u>18</u>
<u>Coarse sand & gravel</u>	<u>37</u>	<u>55</u>
<u>met to coarse sand</u>	<u>35</u>	<u>90</u>
<u>stop bit while still in sand</u>		

Information upon completion of well:

CODED

(1) Diameter: 2" inches.
 (2) Total Depth: 90' feet.
 (3) Water Level: 58' feet below top of ground.
 (4) Cased to: 84', Size: 2"
 (5) Screen: Size 1 1/4", Length 5'
7 slot Johnson S. S.
 (6) Were any formations sealed against pollution?
 _____ yes, X no.

If YES depth of formation _____
 Why _____
 Drillers Remarks: _____

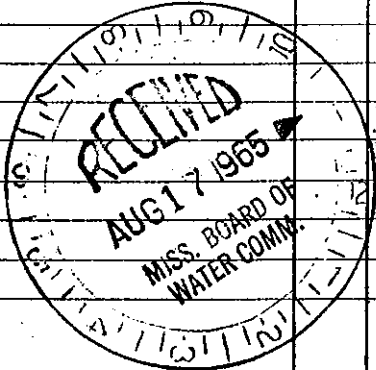

Well No.

(Use Back Side)

Mail this copy to Board of Water Commissioners 429 Miss. St. Jackson, Miss.